
STATE OF OREGON	DES		LL I.D. LABEL# I START CARD #		
WATER SUPPLY WELL REPORT (as required by ORS 537.765 & OAR 690-205-0210)	<i>(</i> /0			1050306	
		/2021 OR	IGINAL LOG #		
LAND OWNER Owner Well I.D. rst Name Last Name	· · ·			- • ·• 、	
mpany AVION WATER		(9) LOCATION OF	-	-	
Idress 60813 PARRELL RD		County <u>DESCHUTES</u> Ty			
w BEND State OR Zin 97	702	Sec <u>14</u> <u>NE</u>			
TYPE OF WORK New Well Deepening	Conversion	Tax Map Number Lat'		Lot	
Alteration (complete 2a & 10) Aband	lonment(complete 5a)	Lat''	" or		
PRE-ALTERATION	ionnien (comprete eu	Long°'	" or		DMS or DI
Dia + From To Gauge Stl Plstc W	1d Thrd	• Street addres		arest address	
Casing:		63223 HAMEHOOK RD)		
Material From To Amt sacks/lbs Seal:	ĺ				
DRILL METHOD	<u></u>	(10) STATIC WAT	ER LEVEL		
X Rotary Air Rotary Mud Cable Auger Cable	able Mud		Date	SWL(psi)	+ SWL(ft)
Reverse Rotary Other		Existing Well / Pre-A			
		Completed Well	5/20/2021		692
PROPOSED USE Domestic Irrigation XC	community	Flo	owing Artesian?	Dry Hole?	
Industrial/ Commericial Livestock Dewatering		WATER BEARING ZONI	ES Depth wa	ater was first found	d 741.00
Thermal Injection Other		SWL Date From	To Est	t Flow SWL(psi)	+ SWL(ft)
BORE HOLE CONSTRUCTION Special Stan	ndard (Attach cop	y) 5/20/2021 741	838	400	692
Depth of Completed Well 838.00 ft.			030	100	
BORE HOLE SEAL	sacks	/			
Dia From To Material From	To Amt lbs				
22 0 38 Bentonite Chips 0 10 20 920 600 600 600	195 263 S lculated 259.72				
19 38 838 Cal	655 396 S				
	lculated 355	(11) WELL LOG	Ground Elevatio	n	
How was seal placed: Method A B KC		Material		From	То
X Other CEMENT		SANDY PUMICE		0	5
Backfill placed from ft. to ft. Material		GRAY LAVA		5	20
Filter pack from <u>660</u> ft. to <u>746</u> ft. Material <u>PEA GF</u>	AVBize pea gravel	BROKEN LAVA		20	23
Explosives used: X Yes Type <u>SHOT PERF</u> Amount		GRAY BASALT BROWN CONGLOMER	ATE	23	31
) ABANDONMENT USING UNHYDRATED BE		MILD BASALT	AIL	31	75
Proposed Amount Actual Amount		BASALT W/SOFT SPOT	ſS	75	118
1		SANDSTONE CONGLO		118	132
CASING/LINER Casing Liner Dia + From To Gauge S	Stl Plstc Wld Thrd	LOST CIRCULATION		132	156
		GRAY BASALT W/SOF	T SPOTS	156	170
	X X H	CONGLOMERATE		170	176
		HARD GRAY BASALT BROWN SANDSTONE		176	188 205
		CONGLOMERATE POL	IR CIRCULATION	205	240
	\cup \cup \Box \Box	CINDERS POUR CIRCU		240	253
Shoe Inside Outside Other Location of	shoe(s)	MILD		253	257
Temp casing Yes Dia 20 From + 0	To _38	SOFT O RETURNS	0) (TD) :	257	280
PERFORATIONS/SCREENS	<u> </u>	BROWN LAVA CONGL	OMERATE	280	301
Perforations Method shot		GRAY BASALT		301	320
Screens Type Material		Date Started 12/23/202	0 Com	pleted <u>5/20/202</u>	1
Perf/ Casing/ Screen Scrn/slot Slo Screen Liner Dia From To width length		(unbonded) Water Well	Constructor Certifi	ication	
Perf Casing 14 728 836 .3 0.3		I certify that the work I			ning, alteration,
		abandonment of this w	ell is in complianc	e with Oregon v	water supply we
		construction standards. I		formation reported	d above are true
		the best of my knowledge		- 4 -	
		License Number <u>1852</u>	D	ate <u>6/9/2021</u>	
WELL TESTS: Minimum testing time is 1 hour		Signed JEB ABBAS (F-filed)		
	Flowing Artesian		,		
	Duration (hr)	(bonded) Water Well Co			
400 837	1	I accept responsibility fo			
		work performed on this w			
		performed during this ti	me is in compliand	re with Dreams	
		performed during this ti construction standards. T			
Temperature 53 °F Lab analysis Yes By	unt 127 ppm	construction standards. T	his report is true to th	ne best of my know	
Temperature 53 °F Lab analysis Yes By Water quality concerns? Yes (describe below) TDS amo From To Description	unt <u>137 ppm</u> Amount Units		his report is true to th		
Water quality concerns? Yes (describe below) TDS amo	unt <u>137 ppm</u> Amount Units	construction standards. T	his report is true to th	ne best of my know	

ORIGINAL - WATER RESOURCES DEPARTMENT THIS REPORT MUST BE SUBMITTED TO THE WATER RESOURCES DEPARTMENT WITHIN 30 DAYS OF COMPLETION OF WORK Form Version:

WATER SUPPLY WELL REPORT -

continuation page

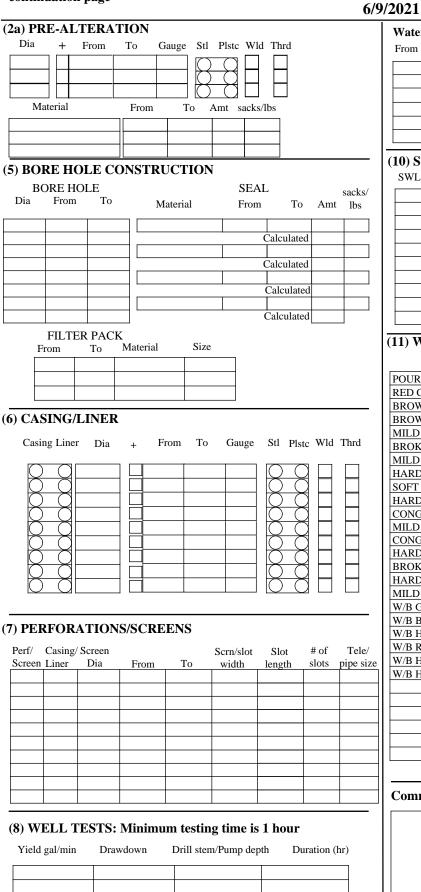

WELL I.D. LABEL# L 142104 START CARD # 1050306 ORIGINAL LOG

Water Ouality Concerns

DESC 62703

From	То	Description	Amount	Units

(10) STATIC WATER LEVEL

SWL Date	From	То	Est Flow	SWL(psi)	+	SWL(ft)
					-	
					-	
					-	

(11) WELL LOG

Material	From	То
POUR CIRCULATION	320	355
RED CINDER & LAVA SOFT CAVING	355	362
BROWN BROKEN LAVA	362	374
BROWN SANDSTONE	374	398
MILD BROWN BASALT	398	415
BROKEN BROWN BASALT	415	421
MILD BROWN BASALT	421	472
HARD GRAY BASALT	472	496
SOFT	496	528
HARD GRAY BASALT	528	536
CONGLOMERATE	536	547
MILD BASALT W/CLAYSEAMS	547	551
CONGLOMERATE	551	610
HARD BASALT	610	614
BROKEN	614	645
HARD GRAY BASALT	645	663
MILD W/SOFT SPOTS	663	719
W/B GRAY FRACTURED BASALT	719	741
W/B BROKEN VESCULAR BROWN BASALT	741	792
W/B HARD BASALT	792	794
W/B RED AND GRAY BROKEN BASALT	794	831
W/B HARD GRAY BASALT	831	838
W/B HARD GRAY BASALT	831	838

Comments/Remarks