

STATE OF OREGON WATER SUPPLY WELL REPORT

DESC 63924

WELL I.D. LABEL# L

9911

START CARD #

1054416

ORIGINAL LOG #

DESCHUTES

51137

(as required by ORS 537.545 & 537.765 and OAR 690-205-0210)

1/2/2023

(1) LAND OWNER

Owner Well I.D. MAIN HOUSE

First Name DAVID & STACY Last Name WELSH
Company C/O CS CONSTRUCTION
Address 1506 NE 1ST UNIT 1
City BEND State OR Zip 97701

(2) TYPE OF WORK

New Well Deepening Conversion
Alteration (complete 2a & 10) Abandonment(complete 5a)

(2a) PRE-ALTERATION

Casing: Dia + From To Gauge Stl Plstc Wld Thrld
Seal: Material From To Amt sacks/lbs

(3) DRILL METHOD

Rotary Air Rotary Mud Cable Auger Cable Mud
Reverse Rotary Other

(4) PROPOSED USE

Domestic Irrigation Community
Industrial/ Commercial Livestock Dewatering
Thermal Injection Other

(5) BORE HOLE CONSTRUCTION

Special Standard (Attach copy)

Depth of Completed Well 614.00 ft.

Table with columns: Dia, From, To, Material, SEAL, Amt, sacks/lbs. Includes rows for BORE HOLE and Calculated values.

How was seal placed: Method A B C D E

Backfill placed from ft. to ft. Material

Filter pack from ft. to ft. Material Size

Explosives used: Yes Type Amount

(5a) ABANDONMENT USING UNHYDRATED BENTONITE

Proposed Amount Actual Amount

(6) CASING/LINER

Table with columns: Casing, Liner, Dia, From, To, Gauge, Stl, Plstc, Wld, Thrld

Shoe Inside Outside Other Location of shoe(s)

Temp casing Yes Dia From + To

(7) PERFORATIONS/SCREENS

Perforations Method

Screens Type Material

Table with columns: Perf/Screen, Casing/Liner, Dia, From, To, Scrn/slot width, Slot length, # of slots, Tele/pipe size

(8) WELL TESTS: Minimum testing time is 1 hour

Pump Bailer Air Flowing Artesian

Yield gal/min Drawdown Drill stem/Pump depth Duration (hr)

Table with 4 columns: Yield gal/min, Drawdown, Drill stem/Pump depth, Duration (hr)

Temperature 54 F Lab analysis Yes By

Water quality concerns? Yes (describe below) TDS amount 113 ppm

Table with columns: From, To, Description, Amount, Units

(9) LOCATION OF WELL (legal description)

County DESCHUTES Twp 17.00 S N/S Range 11.00 E E/W WM

Sec 1 SW 1/4 of the NE 1/4 Tax Lot 405

Tax Map Number Lot

Lat or 44.13140115 DMS or DD

Long or -121.35092528 DMS or DD

Street address of well Nearest address

64311 HIGH MOWING LN (MAIN HOUSE)

(10) STATIC WATER LEVEL

Table with columns: Existing Well / Pre-Alteration, Date, SWL(psi), SWL(ft)

Flowing Artesian? Dry Hole?

WATER BEARING ZONES

Depth water was first found 466.00

SWL Date From To Est Flow SWL(psi) SWL(ft)

Table with columns: SWL Date, From, To, Est Flow, SWL(psi), SWL(ft)

(11) WELL LOG

Ground Elevation

Table with columns: Material, From, To

Date Started 12/5/2022 Completed 12/5/2022

(unbonded) Water Well Constructor Certification

I certify that the work I performed on the construction, deepening, alteration, or abandonment of this well is in compliance with Oregon water supply well construction standards.

License Number 758 Date 1/1/2023

Signed THOMAS PECK (E-filed)

(bonded) Water Well Constructor Certification

I accept responsibility for the construction, deepening, alteration, or abandonment work performed on this well during the construction dates reported above.

License Number 1720 Date 1/2/2023

Signed JACK ABBAS (E-filed)

Contact Info (optional)

WATER SUPPLY WELL REPORT - Map with location identified must be attached and shall include an approximate scale and north arrow

DESC 63924

1/2/2023

Map of Hole

<b>STATE OF OREGON WELL LOCATION MAP</b>	<b>Oregon Water Resources Department</b> 725 Summer St NE, Salem OR 97301 (503)986-0900	
This map is supplemental to the WATER SUPPLY WELL REPORT		
<b>LOCATION OF WELL</b>	<b>Well Label: 9911</b>	
Latitude: 44.13140115 Datum: WGS84	<b>Printed: January 1, 2023</b>	
Longitude: -121.35092528	DISCLAIMER: This map is intended to represent the approximate location the well. It is not intended to be construed as survey accurate in any manner.	
Township/Range/Section/Quarter-Quarter Section: WM17.00S11.00E1SWNE	Provided by well constructor	
Address of Well: 64311 HIGH MOWNG LANE MAIN HOUSE		



# Deschutes County Property Information - Dial

Overview Map




Source: Esri, Maxar, Earthstar Geographics, and the GIS User Community, Deschutes County GIS

Map and Taxlot: 1711040000405

RECEIVED

APR 03 2023

OWRD  
SALEM, OREGON

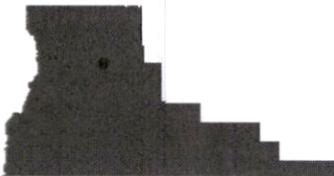

THIS MAP WAS PREPARED FOR  
ASSESSMENT PURPOSE ONLY


SECTION 1 T.17S. R.11E. W.M.  
DESCHUTES COUNTY

17 11 01

6/8/2022

1" = 400'

Cancelled Nos.  
401  
403  
1000

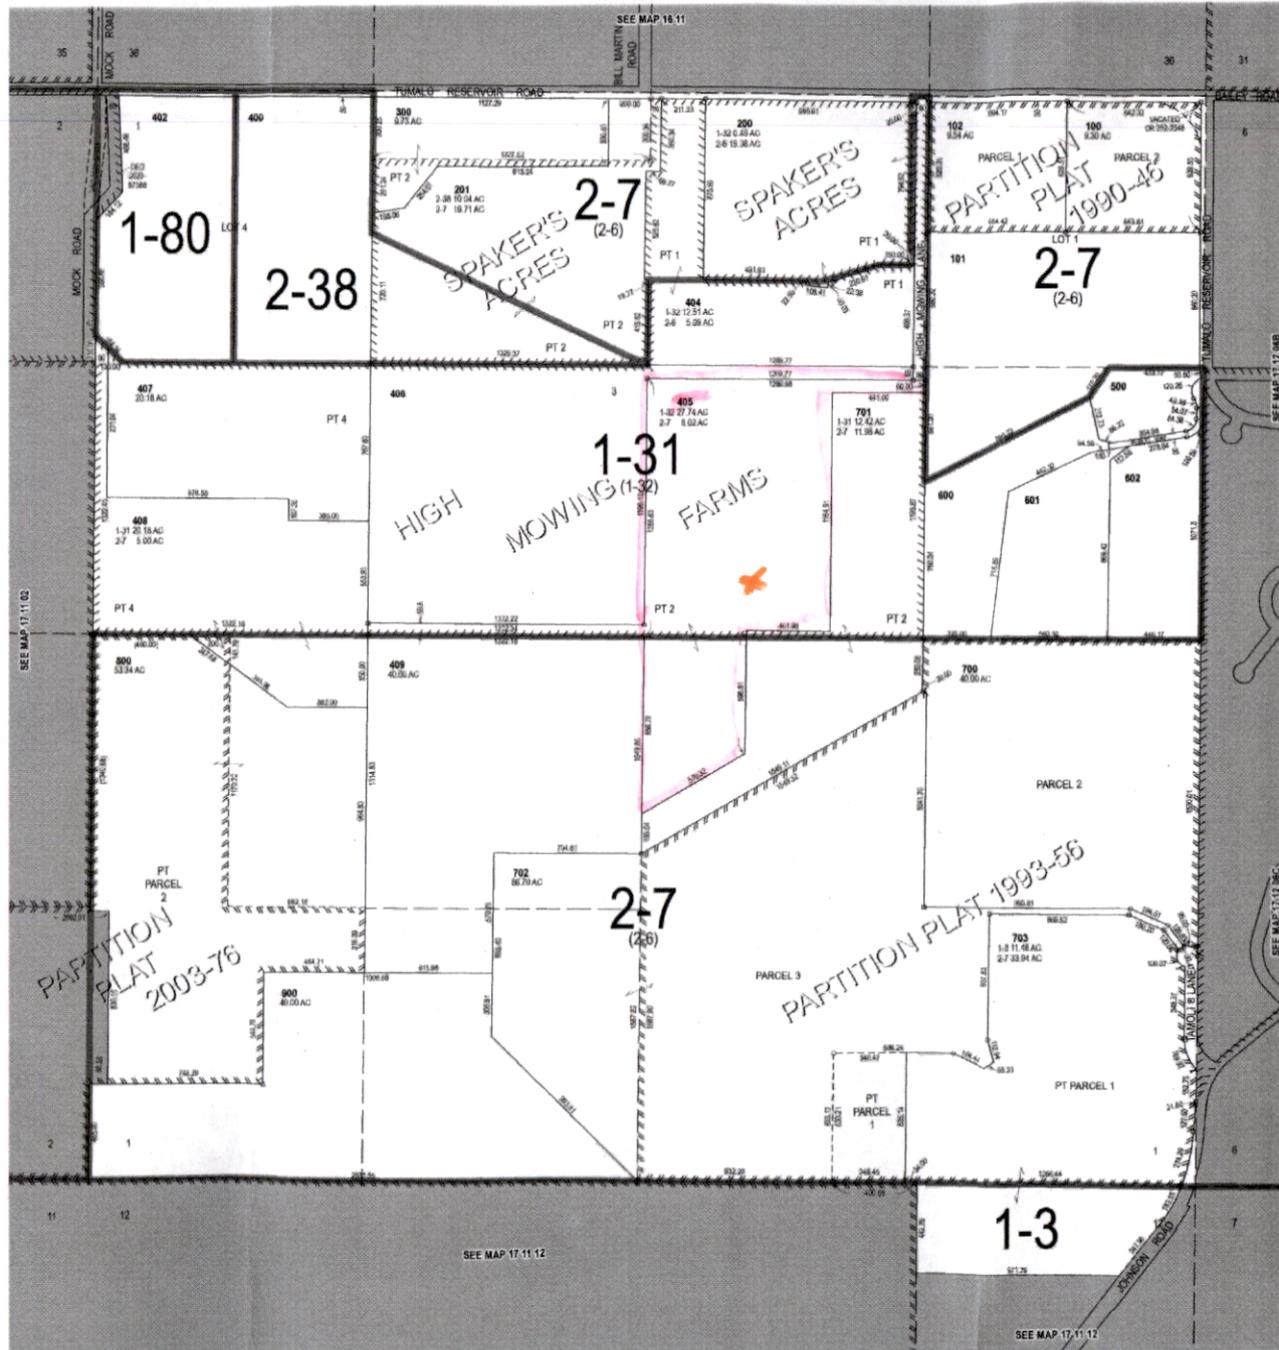

RECEIVED

APR 03 2023

OWRD  
SALEM, OREGON

17 11 01