

WATER SUPPLY WELL REPORT - Map with location identified must be attached and shall include an approximate scale and north arrow

DESC 65092

11/26/2024

Map of Hole

STATE OF OREGON WELL LOCATION MAP

This map is supplemental to the WATER SUPPLY WELL REPORT

Oregon Water Resources Department

725 Summer St NE, Salem OR 97301
(503)986-0900



LOCATION OF WELL

Latitude: 44.14278000 Datum: WGS84

Longitude: -121.36438000

Township/Range/Section/Quarter-Quarter Section:

WM16.00S11.00E35NESE

Address of Well:


64757 MOCK RD, BEND, OR 97701

Well Label: 66553

Printed: November 26, 2024

DISCLAIMER: This map is intended to represent the approximate location the well. It is not intended to be construed as survey accurate in any manner.

Provided by well constructor

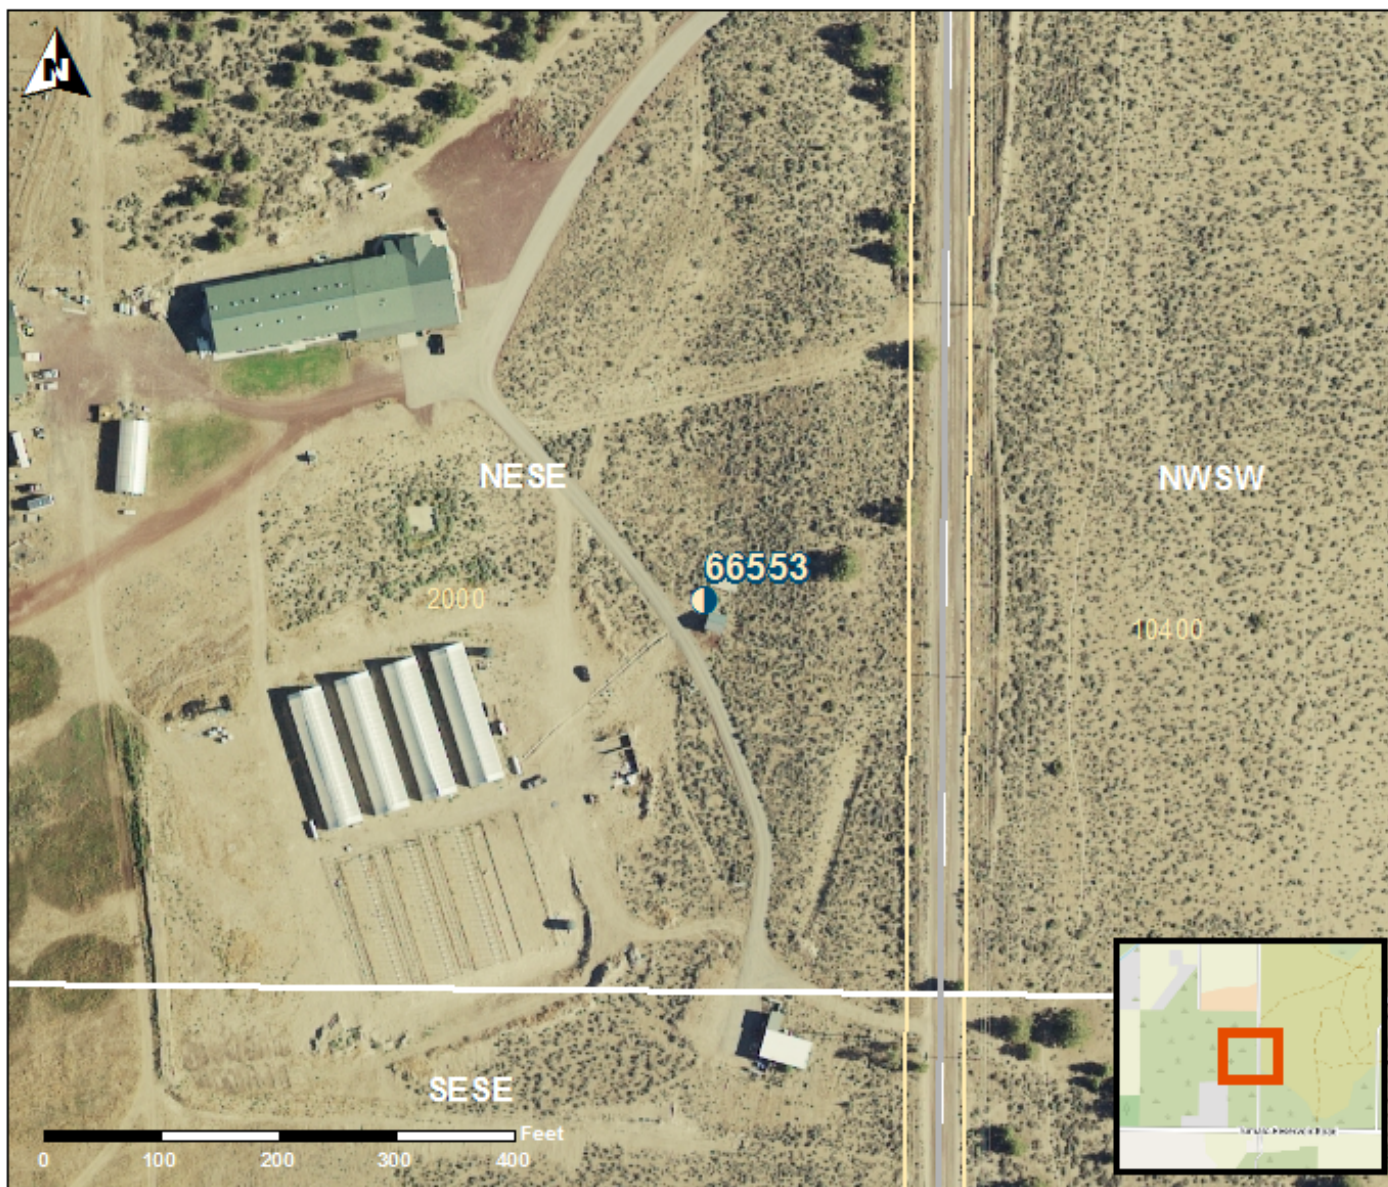

11/26/2024

Map of Hole

