


WATER SUPPLY WELL REPORT - Map with location identified must be attached and shall include an approximate scale and north arrow

DESC 65445

9/4/2025

Map of Hole

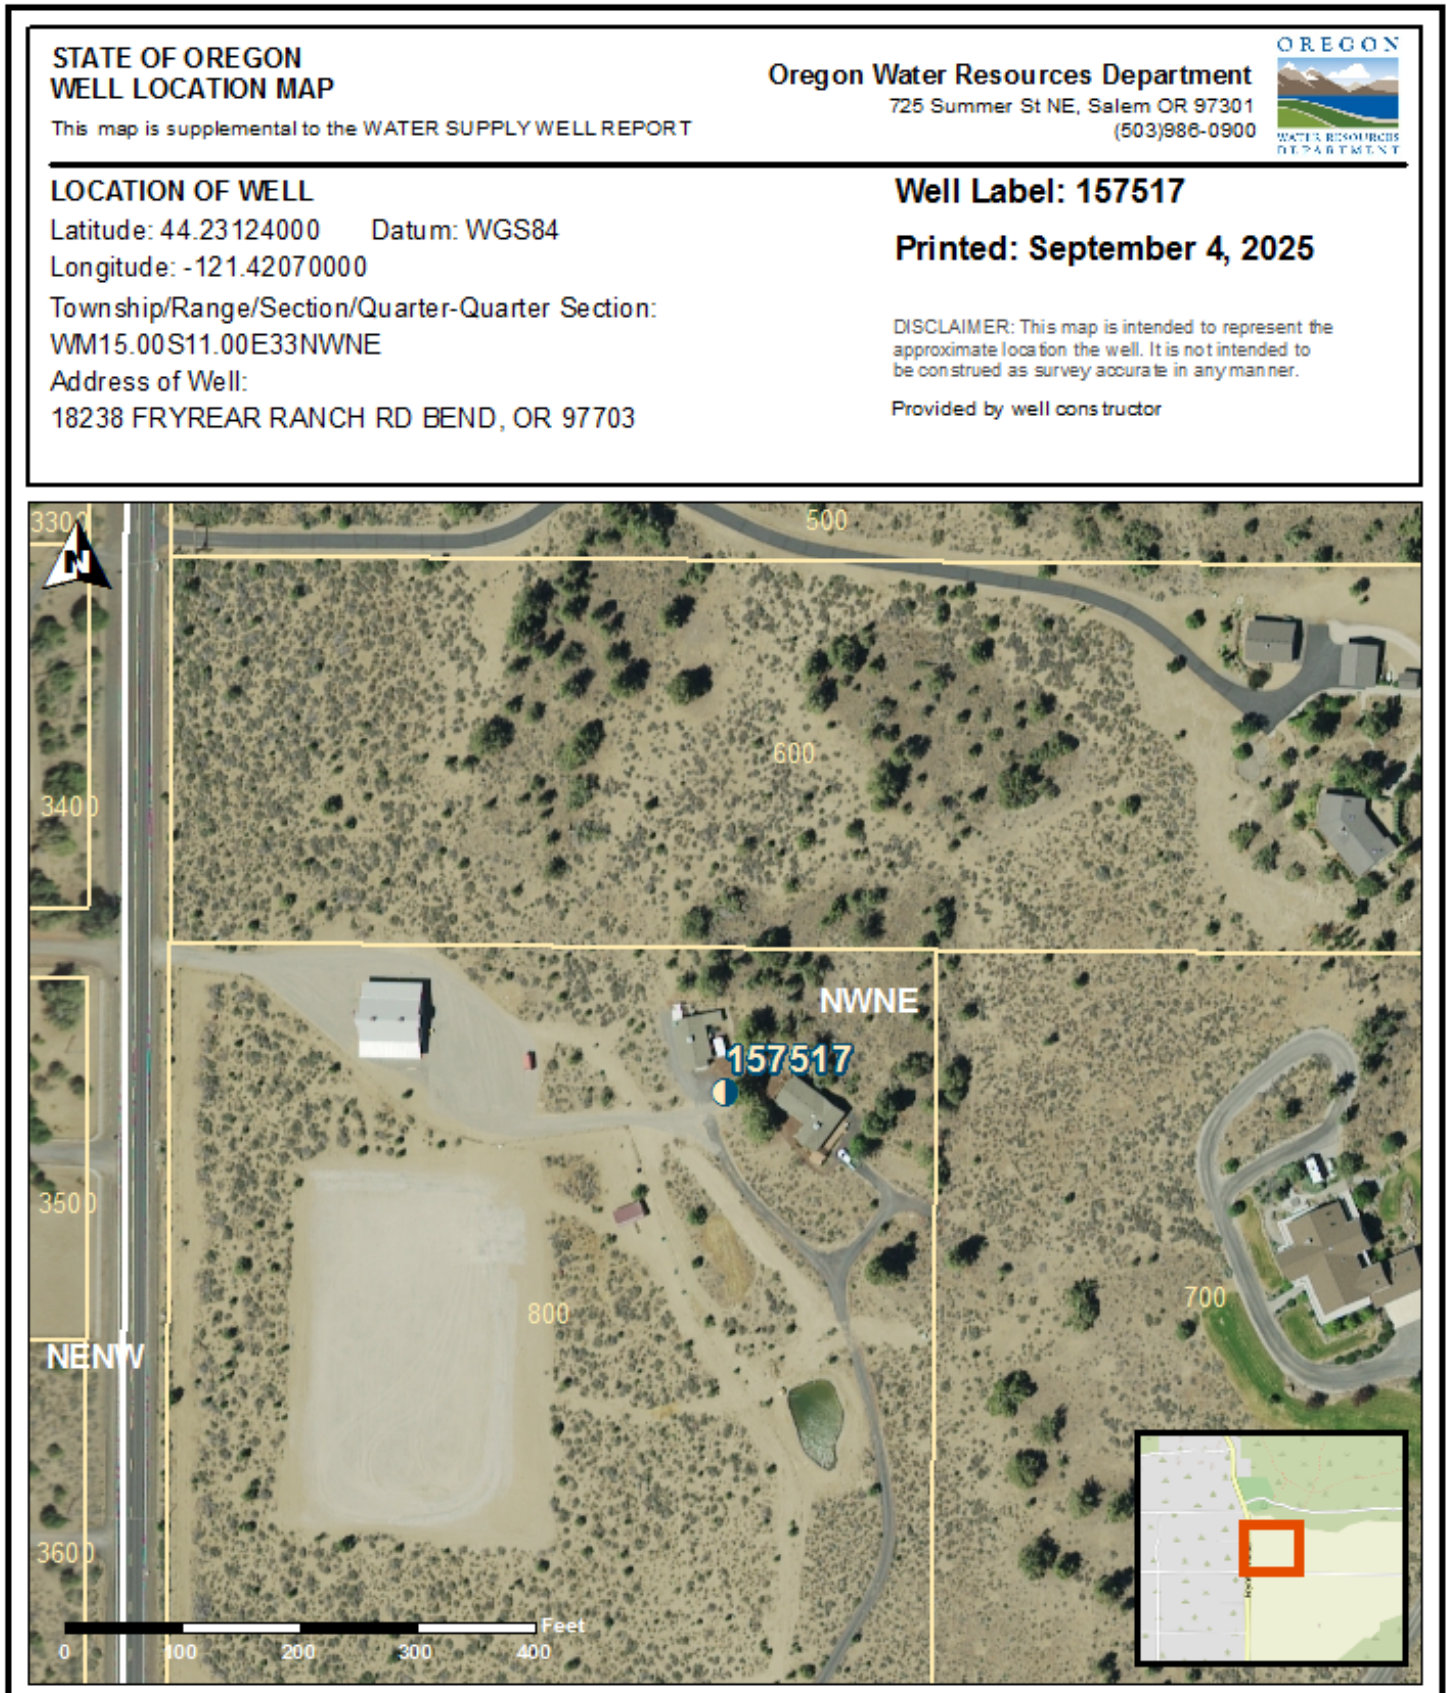

9/4/2025

Map of Hole

