


New exempt use wells must be submitted with a map and recording fee.

WATER SUPPLY WELL REPORT - Map with location identified must be attached and shall include an approximate scale and north arrow

DESC 65712

6/5/2026

Map of Hole

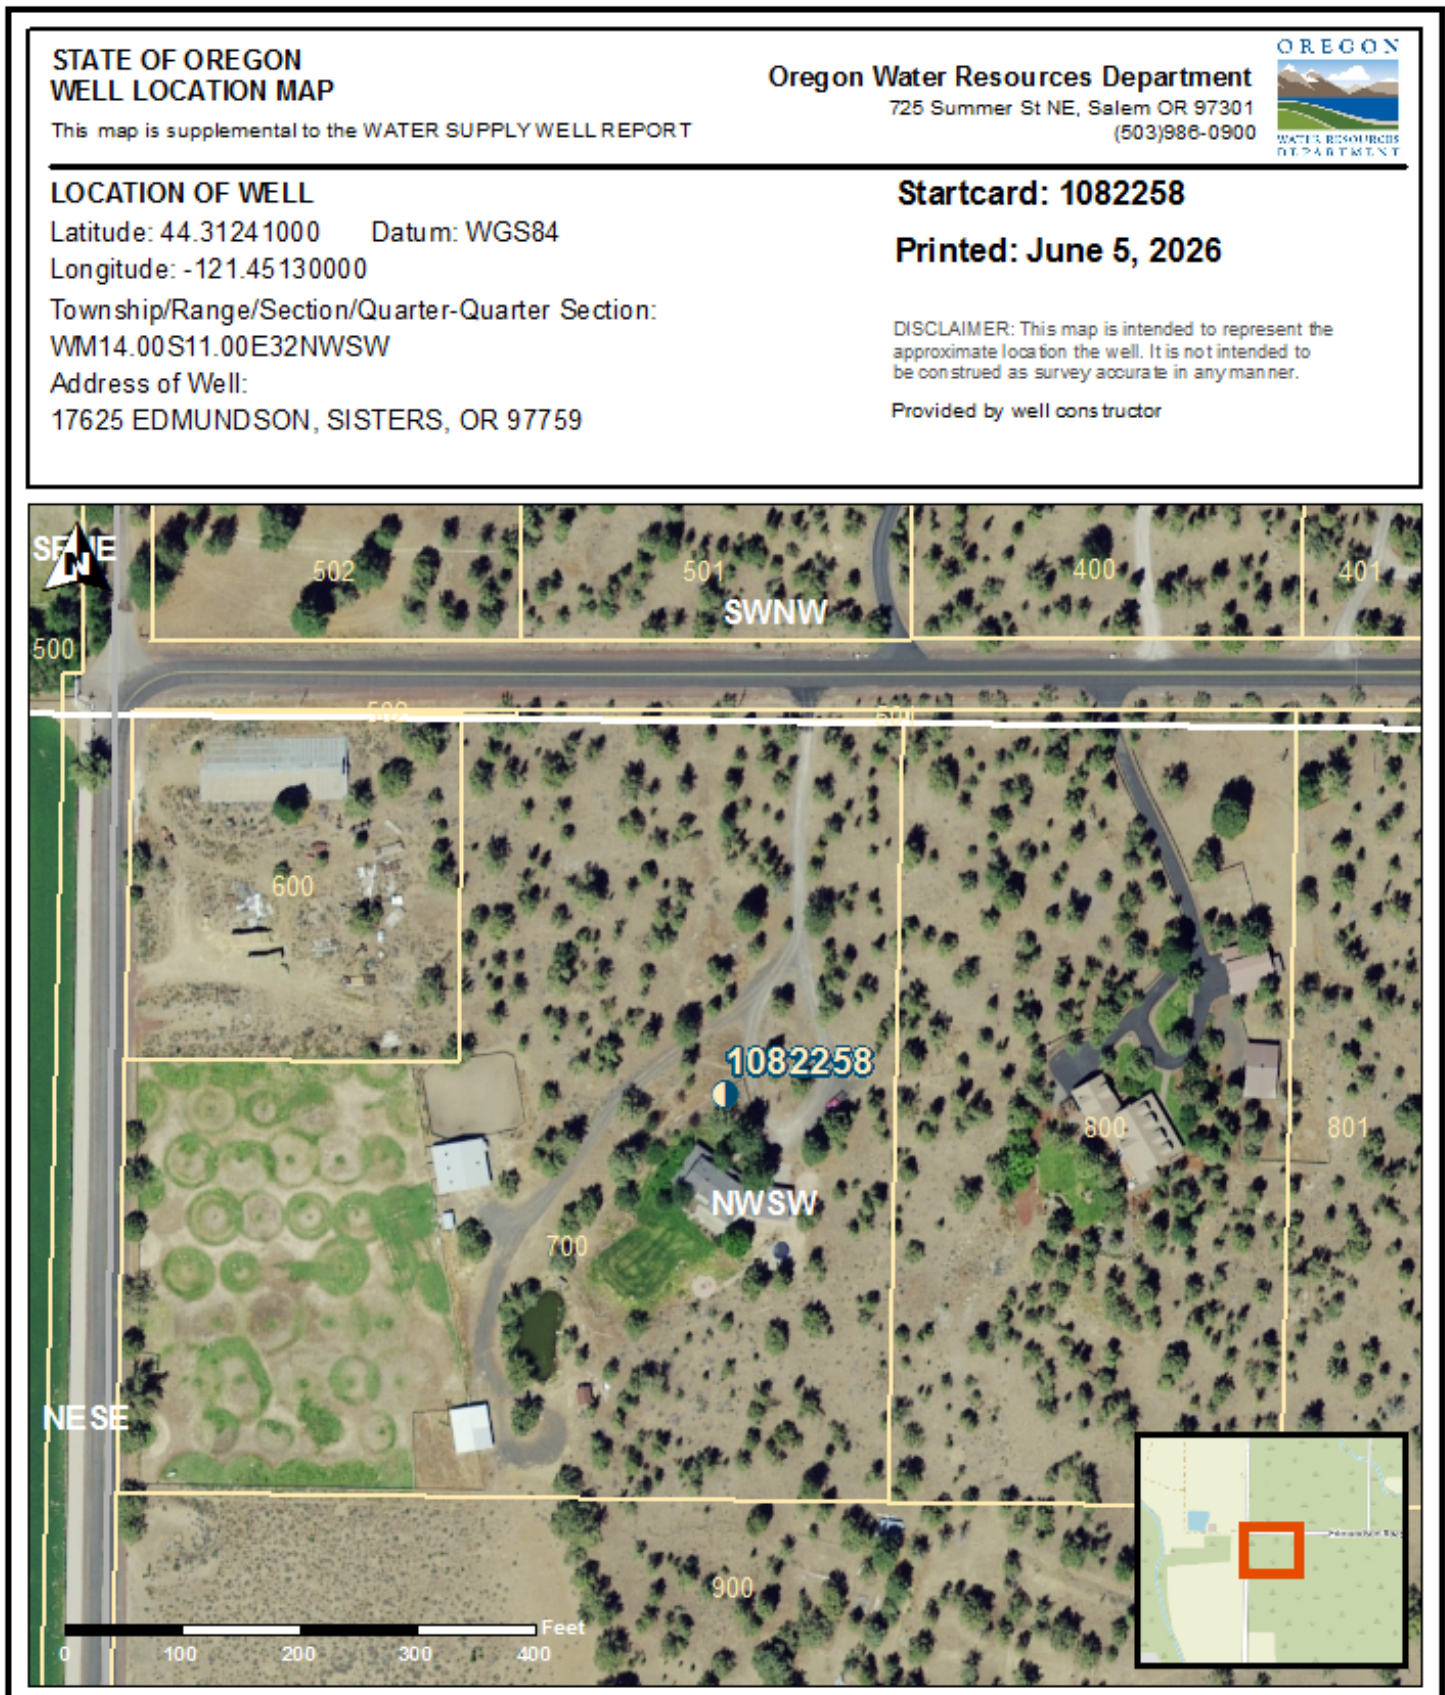

6/5/2026

Map of Hole

