


New exempt use wells must be submitted with a map and recording fee.

WATER SUPPLY WELL REPORT - Map with location identified must be attached and shall include an approximate scale and north arrow

DESC 65795

8/6/2026

Map of Hole

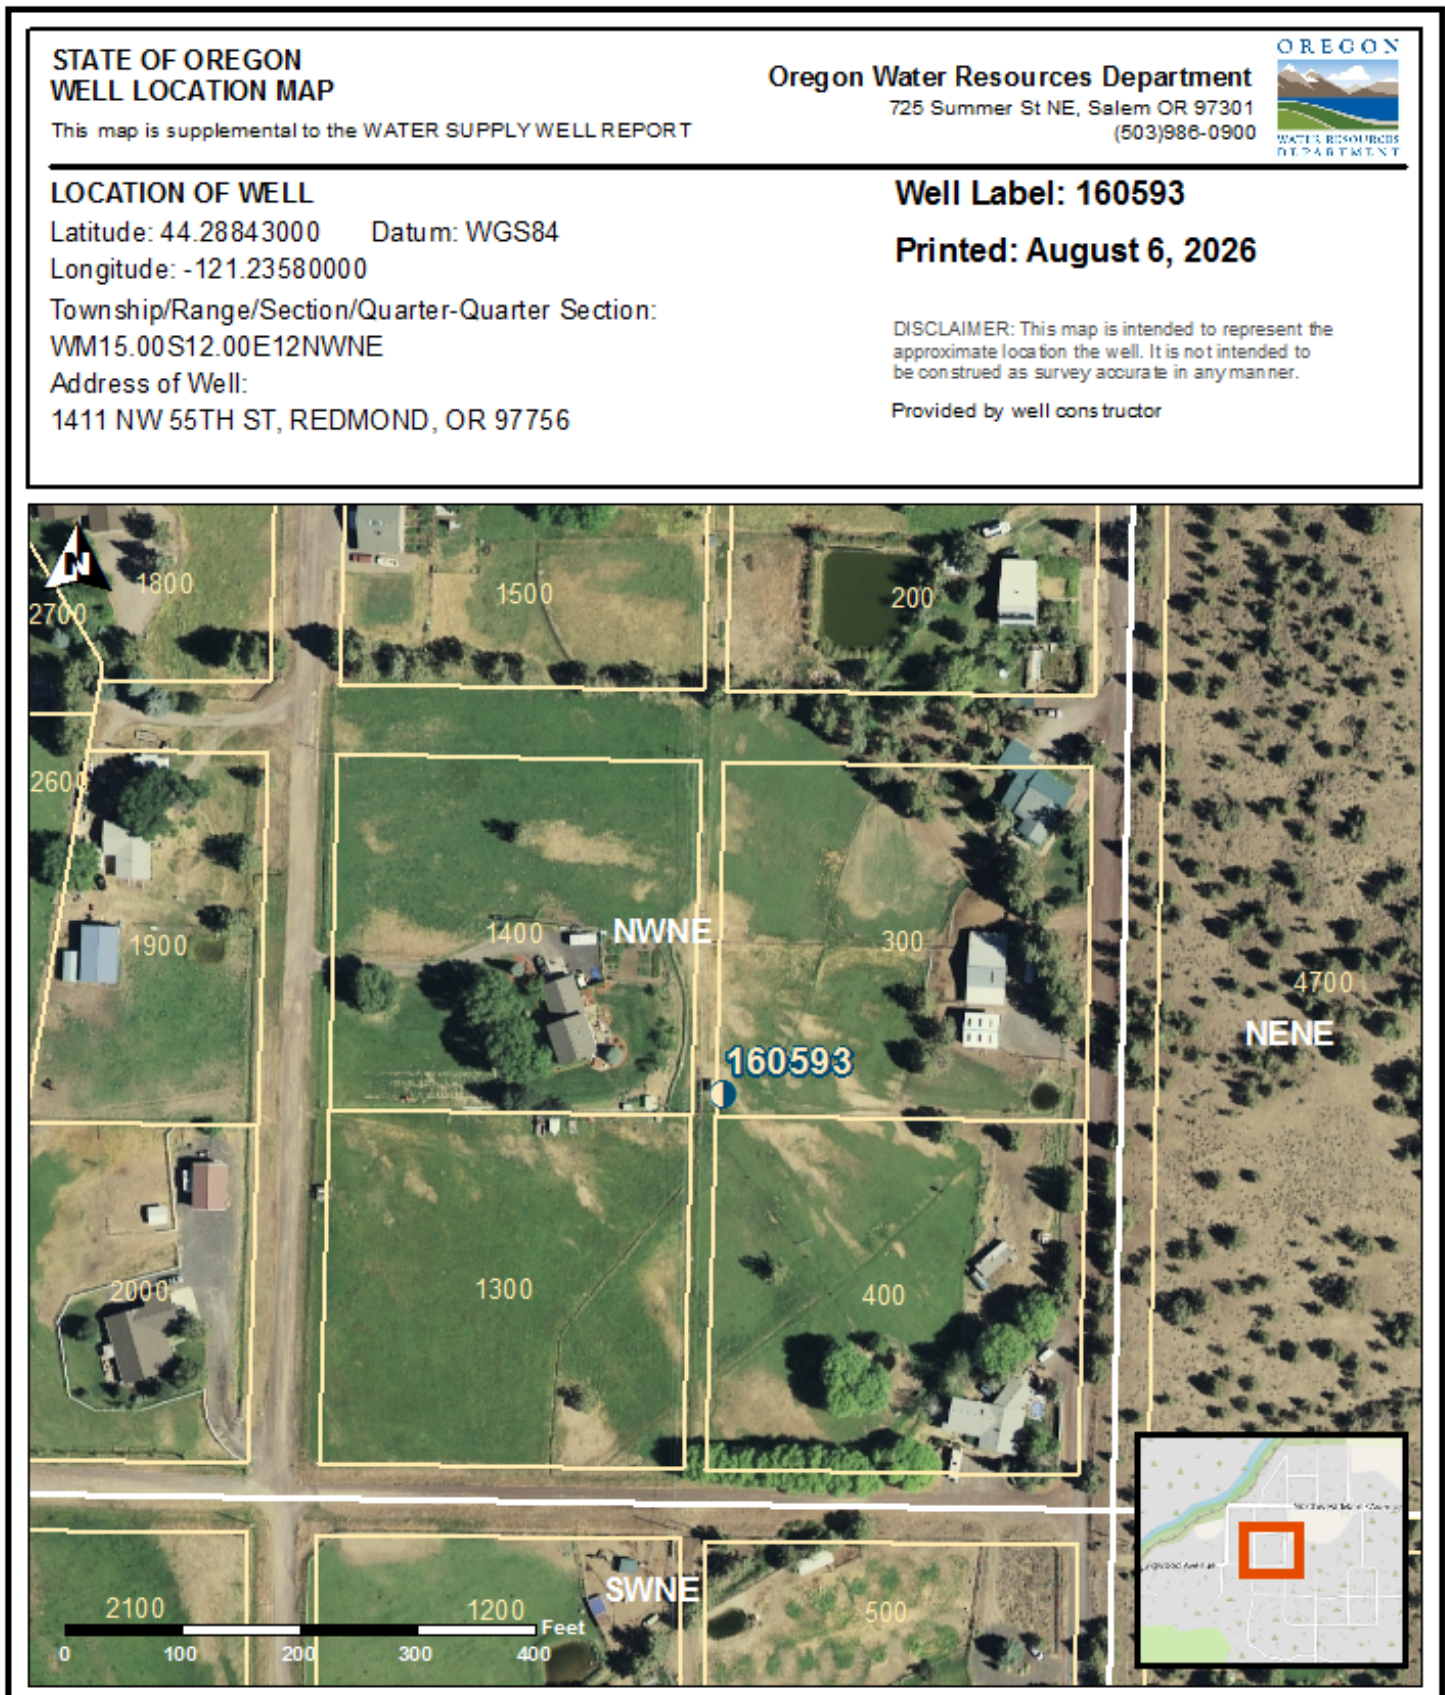

8/6/2026

Map of Hole

