
NOTICE TO WATER WELL CONTRACTOR

The original and first copy of this eports

are to be filed with the

WATER WELL REPORT

WATER RESOURCES DEPARTMENT, APR 10 1981 STATE OF OREGON SALEM, OREGON 97310 (Please type or print) within 30 days from the data TER RESOURCES DEPT (Do not write above this line) SALEM. OREGON

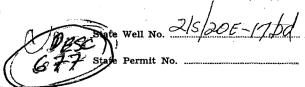

(1) OWNER:	(10) LOCATION OF WELL:		,	
Name R. L. COATS	County Deschares Driller's well number 5			
Address 63285 SHYLING ROAD	SE 1/4 N/6/1/4 Section 17 T. 2/5 R. 20 E W.M.			
BOND OR 97701	Bearing and distance from section or subdivision corner			
(2) TYPE OF WORK (check):				
New Well 🗗 Deepening 🗌 Reconditioning 🗍 Abandon 🗎	-			
If abandonment, describe material and procedure in Item 12.	(11) WATER LEVEL: Completed well.			
(3) TYPE OF WELL: (4) PROPOSED USE (check):	Depth at which water was first found 216 ~ 260 ft.			
Rotary # Driven D				
Cable		surface. I	Date 4	~~~~
Dug Bored Irrigation Test Well Other	Artesian pressure lbs. per squar	re inch. I	Date	
CASING INSTALLED: Threaded Welded	(12) WELL LOG: Diameter of well 1		. 7.	3 1/2
16 " Diam from +2 ft. to -/8 ft. Gage r 250				
Nea / 2 " Diam. from + 2 ft. to 298 ft. Gage 250	Depth drilled 300 ft. Depth of completed well ft.			
" Diam. fromft. toft. Gage	Formation: Describe color, texture, grain size and structure of materials; and show thickness and nature of each stratum and aquifer penetrated,			
PERFORATIONS: Perforated? This I No	with at least one entry for each change of forma	tion. Repo	rt each	change in
Terrorated, agrics 110.	position of Static Water Level and indicate prin	icipai wat	er-bearn	ig strata.
Type of perforator used	MATERIAL	From	То	·s w
Size of perforations /8 in. by 6 in.	SEND	0	3	GPM
//20 perforations from /60 ft. to 300 ft.	CLZY Y GREVEL		35	
perforations from ft. to ft.	LAMENTOD GRZUEL	35	70	
perforations from ft. to ft.	BROWN SILTSTONE	 	105	=
(7) SCREENS: Well screen installed? I Ves to Wo	BLUE CLEY STONE	105	135	
(1) SCREENS: Well screen installed? Yes No Manufacturer's Name	BROWN BOSELT	135	190	 -
Type Model No.	CINDERS, COMENTED	190	216	
Diam. Slot size Set from ft. to ft.	ROD & BROWN CINPERS	2/6	260	700+
Diam. Slot size Set from	IN CINDERS	260	300	2000
	DECEIVED			-
(8) WELL TESTS: Drawdown is amount water level is lowered below static level HARNOY CO	MEDELAFO			
Was a pump test made? Yes \(\subseteq No If yes, by whom? From SUPPL	MAY 3.8 1981			
meld: 26 10 gal./min. with 45 ft. drawdown after hrs.				
" " "	WATER RESOURCES DEPT			
" " "	SALEM, OREGON			
Bailer test gal./min. with ft. drawdown after hrs.	£			
And of the second secon		 -		
		<u> </u>		
perature of water 56 Depth artesian flow encountered ft.	Work started 2 18 19 8 / Complete	ed (2-22	2 19 5/
(9) CONSTRUCTION:	Date well drilling machine moved off of well	2	-22	19 8/
Well seal-Material used PORTLND COMONT	Drilling Machine Operator's Certification:			
Well sealed from land surface to 18 ft.	This well was constructed under my			
Diameter of well bore to bottom of sealin.	Materials used and information reported above are true to my best knowledge and benefit			
Diameter of well bore below seal	[Signed] // // // // // // Data 2-22 to 81			
Number of sacks of cement used in well seal sacks	(Drilling Machine Operator)			
How was cement grout placed? TROMIC	Drilling Machine Operator's License No.			
	Water Wall Contractoris Contillation			
	Water Well Contractor's Certification:			
	This well was drilled under my jurisdiction and this report is true to the best of my knowledge and belief.			
Was a drive shoe used? Yes No Plugs Size: location ft.	Name Land Burd well Drilling Inc			
Did any strata contain unusable water? Yes No	(Person, firm or corporation) (Type or print)			
Type of water? depth of strata	Address 5543 Sw Douglas, Bulliton ore			
Method of sealing strata off	- D */			
Was well gravel packed? Yes No Size of gravel:	[Signed] (Water Well Contr	actor)		
Gravel placed from ft. to ft.	Contractor's License No. 544 Date	2-20	2	108/
				.,