

21S.110E/15ca

Desc  
9009

(START CARD) # 537089

Signed W. J. P. P. WWC Number 1453  
Date 9-11-93

## FOR WATER RESOURCES DEPARTMENT USE ONLY

Date Postmarked 6-2-93  
 Date Hand-delivered \_\_\_\_\_  
 Watermaster Initials \_\_\_\_\_

W. 53709  
 WRD Receipt 100595  
 Date Fee Received \_\_\_\_\_

CHECK NO. \_\_\_\_\_

RECEIVED

# START CARD

## NOTICE OF BEGINNING OF WELL CONSTRUCTION

(as required by ORS 537.762)

JUN - 3 1993

This form must be completed, signed by both the owner (or authorized agent) and constructor, and the original mailed or delivered to the Water Resources Department, 3850 Portland Road NE, Salem, OR 97310, no later than the day construction, alteration, conversion or abandonment work begins. A **\$75 fee shall accompany all notices for new well construction or conversion of an existing hole not previously used as a water well** (make checks payable to the Water Resources Department). Notices meeting this requirement but received without the required fee will not be accepted as properly and timely filed. The Water Resources Commission has authority to impose civil penalties for failure to submit the required \$75 fee with the start card and for failure to submit cards prior to beginning any construction, alteration, conversion or abandonment work.

Owner's name and mailing address Harold Watton  
53637 Big Timber Dr  
Le Pine OR 97739


Check type of work: Fee Required ☒ New construction ☐ Conversion No Fee Required ☐ Repair ☐ Deepening ☐ Recondition ☐ Abandonment

Proposed Commencement Date 6-21-93 Existing or Proposed Well Depth 40 Diameter 6"

Check Use: ☒ Domestic ☐ Community ☐ Industrial ☐ Irrigation ☐ Monitoring  
☐ Thermal ☐ Injection ☐ Other \_\_\_\_\_

Proposed Well Location: County Deschutes Owner's Well Id. No. \_\_\_\_\_

Township Tall Pine (N or S) Range 10 (E or W) Section 15C0

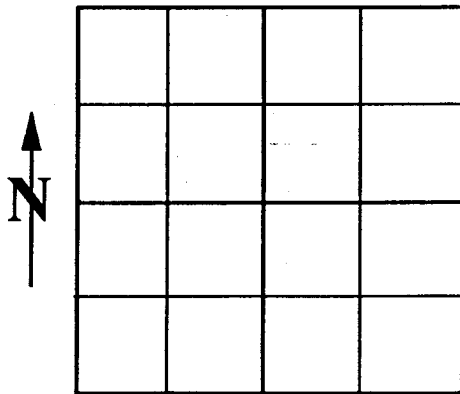

1. A 1/4 of C 1/4 of above section

2. Street address of well location 53637 Big Timber Dr

3. Tax lot number of well location 8200

4. Attach map with location identified.  
 (See reverse of this form for approved maps)

5. Show well location within 1/4, 1/4 of section grid at left.

We hereby certify that we have read the back of this form, and that to the best of our knowledge the information provided herein is accurate and the well is being properly located from septic tanks, septic drain fields and other hazards. (See #2 on back)

Harold Watton  
 Owner's signature

Michael Prodan  
 Bonded Water / Monitor Well Constructor

Title \_\_\_\_\_ Date 6-21-93

License No. 1458

586-5283  
 Home phone

Work phone \_\_\_\_\_

Company \_\_\_\_\_

NOTE: This is not a water right application. The owner is responsible for obtaining a water right through the Water Resources Department, if required.