

JAN 24 1990

DOUG 5256 DOUG

265/3w/11ab

STATE OF OREGON WATER WELL REPORT (as required by ORS 537.765)

WATER RESOURCES DEPT. SALEM, OREGON 5256

(START CARD) # 15596

(1) OWNER: Name Idlelyld Park Lodge Address P.O. Box 101 City Idlelyld Park State OR Zip 97447

(2) TYPE OF WORK: [X] New Well [ ] Deepen [ ] Recondition [ ] Abandon

(3) DRILL METHOD: [X] Rotary Air [ ] Rotary Mud [ ] Cable [ ] Other

(4) PROPOSED USE: [ ] Domestic [X] Community [ ] Industrial [ ] Irrigation [ ] Thermal [ ] Injection [ ] Other

(5) BORE HOLE CONSTRUCTION: Special Construction approval Yes No Depth of Completed Well 163 ft. Explosives used [ ] [X] Type Amount

Table with columns: HOLE Diameter, From, To, SEAL Material, From, To, Amount sacks or pounds. Row 1: 9 7/8, 0, 29, Cement, 0, 29, 7 sacks. Row 2: 6, 29, 163.

How was seal placed: Method [ ] A [ ] B [X] C [ ] D [ ] E Backfill placed from ft. to ft. Material Gravel placed from ft. to ft. Size of gravel

(6) CASING/LINER: Table with columns: Diameter, From, To, Gauge, Steel, Plastic, Welded, Threaded. Casing: 6, +1, 29, .250, [X], [ ], [X], [ ]. Liner: 4, 3, 163, 160, [ ], [X], [ ], [ ].

Final location of shoe(s) 29 ft.

(7) PERFORATIONS/SCREENS: [X] Perforations Method saw cut [ ] Screens Type Material

Table with columns: From, To, Slot size, Number, Diameter, Tele/pipe size, Casing, Liner. Row 1: 40, 163, 1/8x5, 124, 4, [ ], [X].

(8) WELL TESTS: Minimum testing time is 1 hour [ ] Pump [ ] Bailer [X] Air [ ] Flowing Artesian Yield gal/min Drawdown Drill stem at Time

Temperature of water 51 Depth Artesian Flow Found Was a water analysis done? [ ] Yes [ ] No By whom Did any strata contain water not suitable for intended use? [ ] Too little [ ] Salty [ ] Muddy [ ] Odor [ ] Colored [ ] Other Depth of strata:

(9) LOCATION OF WELL by legal description: County Douglas Latitude Longitude Township 26 N or S, Range 3 E or W, WM. Section 11 NW 1/4 NE 1/4 Tax Lot 200 Lot Block Subdivision Street Address of Well (or nearest address) Idlelyld Park Lodge Idlelyld Park, OR 97447

(10) STATIC WATER LEVEL: 23 ft. below land surface. Date 1/4/90 Artesian pressure lb. per square inch. Date

(11) WATER BEARING ZONES: Table with columns: From, To, Estimated Flow Rate, SWL. Row 1: 53, 54, 7, 23.

(12) WELL LOG: Table with columns: Material, From, To, SWL. Row 1: Brown clay, 0, 11. Row 2: Brown clay/med. boulders, 11, 24. Row 3: Blue claystone, 24, 92, 23. Row 4: Black claystone, 92, 96, 23. Row 5: Blue claystone, 96, 141, 23. Row 6: Green basalt, 141, 152, 23. Row 7: Blue/green basalt, 152, 163, 23.


Date started 1/2/90 Completed 1/4/90

(unbonded) Water Well Constructor Certification: I certify that the work I performed on the construction, alteration, or abandonment of this well is in compliance with Oregon well construction standards. Materials used and information reported above are true to my best knowledge and belief. Signed Date WWC Number

(bonded) Water Well Constructor Certification: I accept responsibility for the construction, alteration, or abandonment work performed on this well during the construction dates reported above. all work performed during this time is in compliance with Oregon well construction standards. This report is true to the best of my knowledge and belief. Signed Date WWC Number 1284

SECTION 11 T.26S. R.3W. W.M.  
DOUGLAS COUNTY

1"=400'

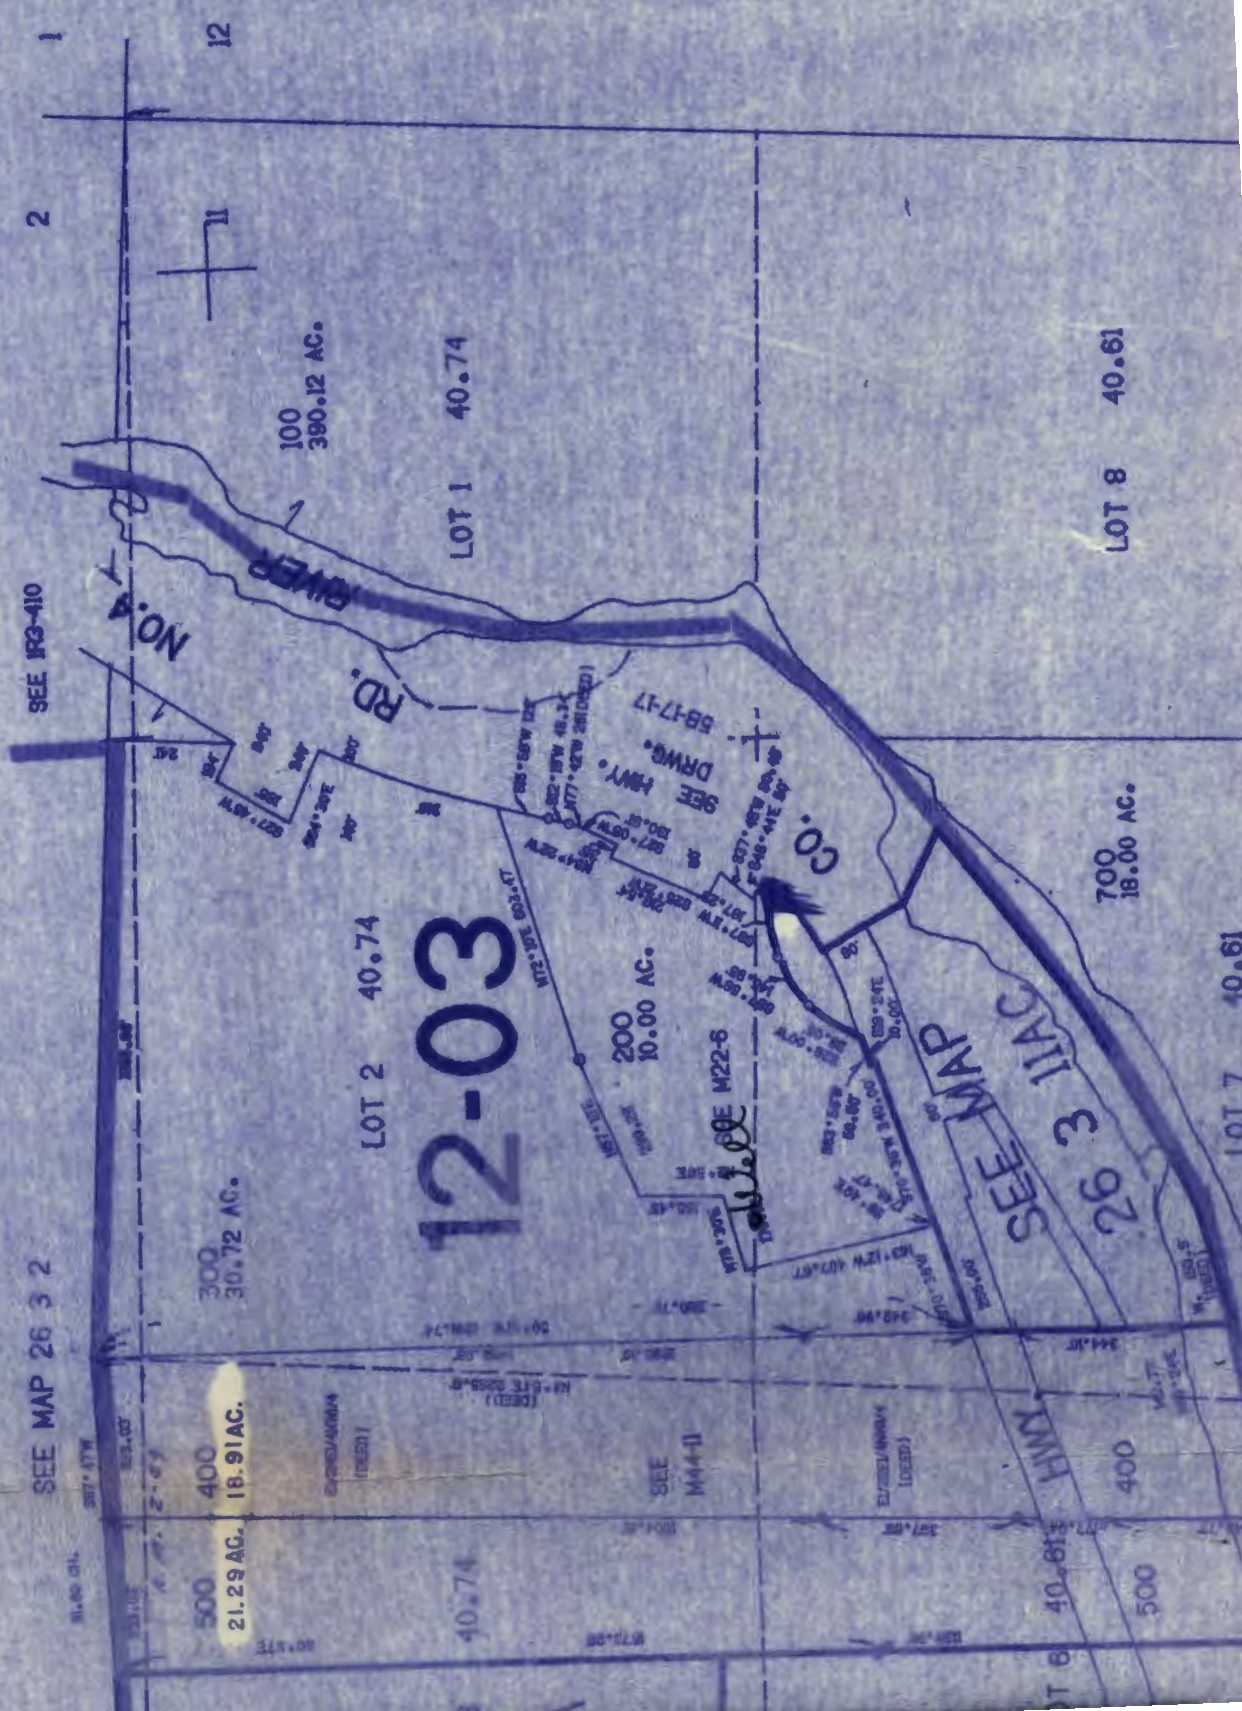

12-03

LOT 2 40.74

LOT 1 40.74

LOT 8 40.61

LOT 7 40.61

700 18.00 AC.

300 30.72 AC.

400 18.91 AC.

500 21.29 AC.

200 10.00 AC.

100 390.12 AC.

SEE MAP 26 3 2

SEE IR3-110

SEE M44-11

SEE M22-6

SEE HWY. DRWG. 58-17-17

SEE MAP 26 3 11AC



