

**STATE OF OREGON**  
**Water Supply Well Report**  
 (as required by ORS 537.765)

DOUG 53022  
 DOUG  
 53022

Received Date:  
 Well ID Tag # L 59367  
 Start Card # 146221

Instructions for completing this report are on the last page of this form.

**(1) Owner** Well Number: 4  
 Name: RICE HILL OWNERS ASSOC.  
 Street: 89140 BRIDGE ST.  
 City: SPRINGFIELD State: OR Zip Code: 97478

**(2) Type of Work**  
 New  Alter (Recondition)  Alter (Repair)  
 Deepening  Abandonment

**(3) Drill Method**  
 Rotary Air  Rotary Mud  Cable  Auger  
 Other:

**(4) Proposed Use**  
 Domestic  Community  Industrial  Irrigation  Injection  
 Livestock  Thermal Other:

**(5) Bore Hole Construction**  
 Special Standards: Depth of completed well: 170.00 ft.  
 Explosives Used: Amount: Type:  

| Hole     |      |       | Seal |      |       | Sacks/lbs |
|----------|------|-------|------|------|-------|-----------|
| Diameter | From | To    | Mtrl | From | To    |           |
| 10.00    | 0.00 | 19.00 | CE   | 0.00 | 19.00 | 8         |
| 6"       | 19   | 170   |      |      |       |           |

How was seal placed? C Other:  
 Back fill placed from: Material:  
 Filter pack from: Size:

**(6) Casing / Liner**  
 Casing/ Liner Diameter From To Gauge Mtrl Weld Thrd at used  
 C 6.00 1.00 -19.00 .250 S

**(7) Perforation / Screens**  
 Perforations: Casing/ Lnr Method  
 Mtrl From To Width Height #Slots Dia. t/pSize Lnr Method  
 Screens: Mtrl From To S Size #Slots Dia. t/pSize Type Gauge

**(8) Well Tests** (Minimum testing time is one hour)  

| Type | Yield | Units | Drawdown | Stem at | Duration |
|------|-------|-------|----------|---------|----------|
| A    | 60.00 | G     | 93.00    | 170.00  | 1.00     |

Temperature of Water: 51 F  
 Was water analysis done?  Depth of artesian flow:  
 by whom?  
 Did any strata contain water unsuitable for use?  Too Little  Salty  
 Muddy  Odor  Colored other:  
 Depth of strata:

**(9) Location of Hole by legal description**  
 County: DOUG Latitude: Longitude:  
 Township: 23.00 S Range: 5.00 W  
 Section: 27 SWSW Lot: Block:  
 Tax Lot: 700 Subdivision:  
 Street Address of Well (or nearest address):  
 300 FT. UP GOODRICH HWY ON LEFT SIDE FROM JOHN LON  
 MAP, with location identified, must be attached.



**(10) Static Water Level**  
 Feet below land surface: 77.0 Date: 06 / 17 / 2002  
 Artesian Pressure: Date:

**(11) Water Bearing Zones**  
 Depth at which water was first found: 140.00 ft.  

| From   | To     | est Flow | swl |
|--------|--------|----------|-----|
| 140.00 | 150.00 | 60.00    | 77  |

**(12) Well Log** Ground Elevation:

| Material                   | From  | To     | swl |
|----------------------------|-------|--------|-----|
| TOPSOIL                    | 0.00  | 1.00   |     |
| BROWN CLAYSTONE MEDIUM     | 1.00  | 12.00  |     |
| BLUE/GRAY SANDSTONE MEDIUM | 12.00 | 170.00 | 77  |

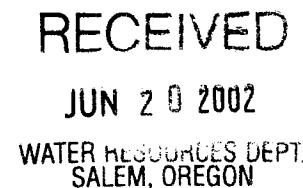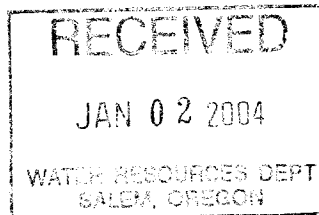

Date Started: 06 / 17 / 2002 Date Completed: 06 / 17 / 2002

**(unbonded) Water Well Constructor Certification:**  
 I certify that the work I perform on the construction, alteration, or abandonment of this well is in compliance with Oregon well construction standards. Materials used and information reported above are true to the best knowledge and belief.  
 Signed by: GEORGE K TURNEY III WWC #: 1722

**(bonded) Water Well Constructor Certification:**  
 I accept responsibility for the construction, alteration, or abandonment work performed on this well during the construction dates reported above. All work performed during this time is in compliance with Oregon well construction standards. This report is true to the best of my knowledge and belief.  
 Signed by: CASEY JONES JR WWC #: 1541  
 CASEY JONES WELL DRILLING Phone: 541-747-2806