STATE OF OREGON
WATER SUPPLY WELL REPORT
(as required by ORS 537.545 & 537.765 and OAR 690-205-0210)

DOUG 60300
9/24/2026

WELL I.D. LABEL# L 161310
START CARD # 1083435
ORIGINAL LOG #

(1) LAND OWNER

Owner Well I.D.
First Name CHRIS & NICOLE Last Name GADDIS
Company
Address 7917 N. MYRTLE RD.
City MYRTLE CREEK State OR Zip 97457

(2) TYPE OF WORK

[X] New Well [ ] Deepening [ ] Conversion
[ ] Alteration (complete 2a & 10) [ ] Abandonment(complete 5a)

(2a) PRE-ALTERATION

	Dia	+	From	To	Gauge	Stl	Plstc	Wld	Thrd
Casing:									

	Material	From	To	Amt	sacks/lbs
Seal:					

(3) DRILL METHOD

[X] Rotary Air [ ] Rotary Mud [ ] Cable [ ] Auger
[ ] Reverse Rotary [ ] Other

(4) PROPOSED USE

[X] Domestic [ ] Irrigation [ ] Community
[ ] Industrial/ Commercial [ ] Livestock [ ] Dewatering
[ ] Thermal [ ] Injection [ ] Other

(5) BORE HOLE CONSTRUCTION

Special Standard [ ] (Attach copy)
Depth of Completed Well 60.00 ft.

BORE HOLE Dia	From	To	SEAL Material	From	To	Amt	sacks/lbs
10	0	27	Bentonite Chips	0	27	14	S
6	27	60			Calculated	13	
					Calculated		

Seal placement method: [ ] A [ ] B [ ] C [ ] D [ ] E [X] Other: POURED & TAMPED
Backfill placed from ft. to ft. Material
Filter pack from ft. to ft. Material Size
Explosives used: [ ] Type Amount
Seal Placement Begin Date 9/14/2026 Begin Time 11 15

(5a) ABANDONMENT USING UNHYDRATED BENTONITE

Proposed Amount Actual Amount

(6) CASING/LINER

C/L	Dia	+	From	To	Gauge	Mat. Type	Wld	Thrd	Shoe	Shoe Location
C	6	X	2.5	27	0.250	ST	X		OUT.	27
L	4		2	60	Sch40	PL				

Temp casing [ ] Yes Dia From + [ ] To

(7) PERFORATIONS/SCREENS

Perforations Method skillsaw
Screens Type Material

Perf/ Screen	Casing/ Liner	Screen Dia	From	To	Scrn/slot width	Slot length	# of slots	Tele/ Pipe size
Perf	Liner	4	20	60	.25	8	50	

(8) WELL TESTS: Minimum testing time is 1 hour

Type of Test	Yield (gal/min)	Drawdown	Drill Stem/ Pump Depth	Duration (hr)
Air	18.5		60	1

Temperature 50 °F Lab analysis [ ] Yes By
Water quality concerns? [ ] Yes (describe below) TDS amount 210 ppm

From	To	Description	Amount	Units

(9) LOCATION OF WELL (legal description)

County DOUGLAS Twp 29.00 S N/S Range 4.00 W E/W WM
Sec 5 SE 1/4 of the NE 1/4 Tax Lot 1100
Tax Map Number Lot
Lat ° ' " or 43.07998717 DMS or DD
Long ° ' " or -123.19078851 DMS or DD
(•) Street address of well ( ) Nearest address
7917 N. MYRTLE RD., MYRTLE CREEK, OR 97457

(10) STATIC WATER LEVEL

	Date	SWL(psi)	+	SWL(ft)
Existing Well / Pre-Alteration				
Completed Well	9/14/2026			9

Flowing Artesian? [ ] Dry Hole? [ ]

WATER BEARING ZONES Depth water was first found 38.00

SWL Date	From	To	Est Flow	SWL(psi)	+	SWL(ft)
9/14/2026	38	40	18.5			9

(11) WELL LOG

Ground Elevation 824.00 FT

Material	From	To
Clay Brown	0	7
Clay/course sand	7	20
Greenstone soft	20	21
Greenstone med/hard	21	38
Greenstone waterbearing	38	40
Greenstone hard	40	56
Greenstone soft	56	57
Greenstone hard	57	60

Construction
Begin Date 9/14/2026 Begin Time 09 25 End Date 9/14/2026

(unbonded) Water Well Constructor Certification

I certify that the work I performed on the construction, deepening, alteration, or abandonment of this well is in compliance with Oregon water supply well construction standards. Materials used and information reported above are true to the best of my knowledge and belief.

License Number Date

Signed

(bonded) Water Well Constructor Certification

I accept responsibility for the construction, deepening, alteration, or abandonment work performed on this well during the construction dates reported above. All work performed during this time is in compliance with Oregon water supply well construction standards. This report is true to the best of my knowledge and belief.

License Number 1686 Date 9/24/2026

Signed TADD MOORE (E-filed)
Drilling Company: Mohr Well Drilling inc.

WATER SUPPLY WELL REPORT - continuation page

DOUG 60300

9/24/2026

WELL I.D. LABEL# L 161310
START CARD # 1083435
ORIGINAL LOG #

(2a) PRE-ALTERATION

Dia	+	From	To	Gauge	Stl	Plstc	Wld	Thrd

Material	From	To	Amt	sacks/lbs

(5) BORE HOLE CONSTRUCTION

BORE HOLE

Dia	From	To

SEAL

Material	From	To	Amt	sacks/lbs
		Calculated		
		Calculated		
		Calculated		
		Calculated		

FILTER PACK

From	To	Material	Size

(6) CASING/LINER

C/L	Dia	+	From	To	Gauge	Mat. Type	Wld	Thrd	Shoe	Shoe Location

(7) PERFORATIONS/SCREENS

Perf/ Screen	Casing/ Liner	Screen Dia	From	To	Scrn/slot width	Slot length	# of slots	Tele/ Pipe size

(8) WELL TESTS: Minimum testing time is 1 hour

Type of Test	Yield (gal/min)	Drawdown	Drill Stem/ Pump Depth	Duration (hr)

Water Quality Concerns

From	To	Description	Amount	Units

(10) STATIC WATER LEVEL

SWL Date	From	To	Est Flow	SWL(psi)	+	SWL(ft)

(11) WELL LOG

Material	From	To

Name of person(s) who assisted with construction and Trainee License # / Helper #

Assistant Name	Type	#

Comments/Remarks

Erik Ellison assisted

WATER SUPPLY WELL REPORT - Map with location identified must be attached and shall include an approximate scale and north arrow

DOUG 60300

9/24/2026

Map of Hole

STATE OF OREGON
WELL LOCATION MAP

This map is supplemental to the WATER SUPPLY WELL REPORT

Oregon Water Resources Department
725 Summer St NE, Salem OR 97301
(503)986-0900

LOCATION OF WELL

Latitude: 43.07998717 Datum: WGS84
Longitude: -123.19078851
Township/Range/Section/Quarter-Quarter Section:
WM29.00S4.00W5SENE
Address of Well:
7917 N. MYRTLE RD., MYRTLE CREEK, OR 97457

Well Label: 161310

Printed: September 24, 2026

DISCLAIMER: This map is intended to represent the approximate location the well. It is not intended to be construed as survey accurate in any manner.
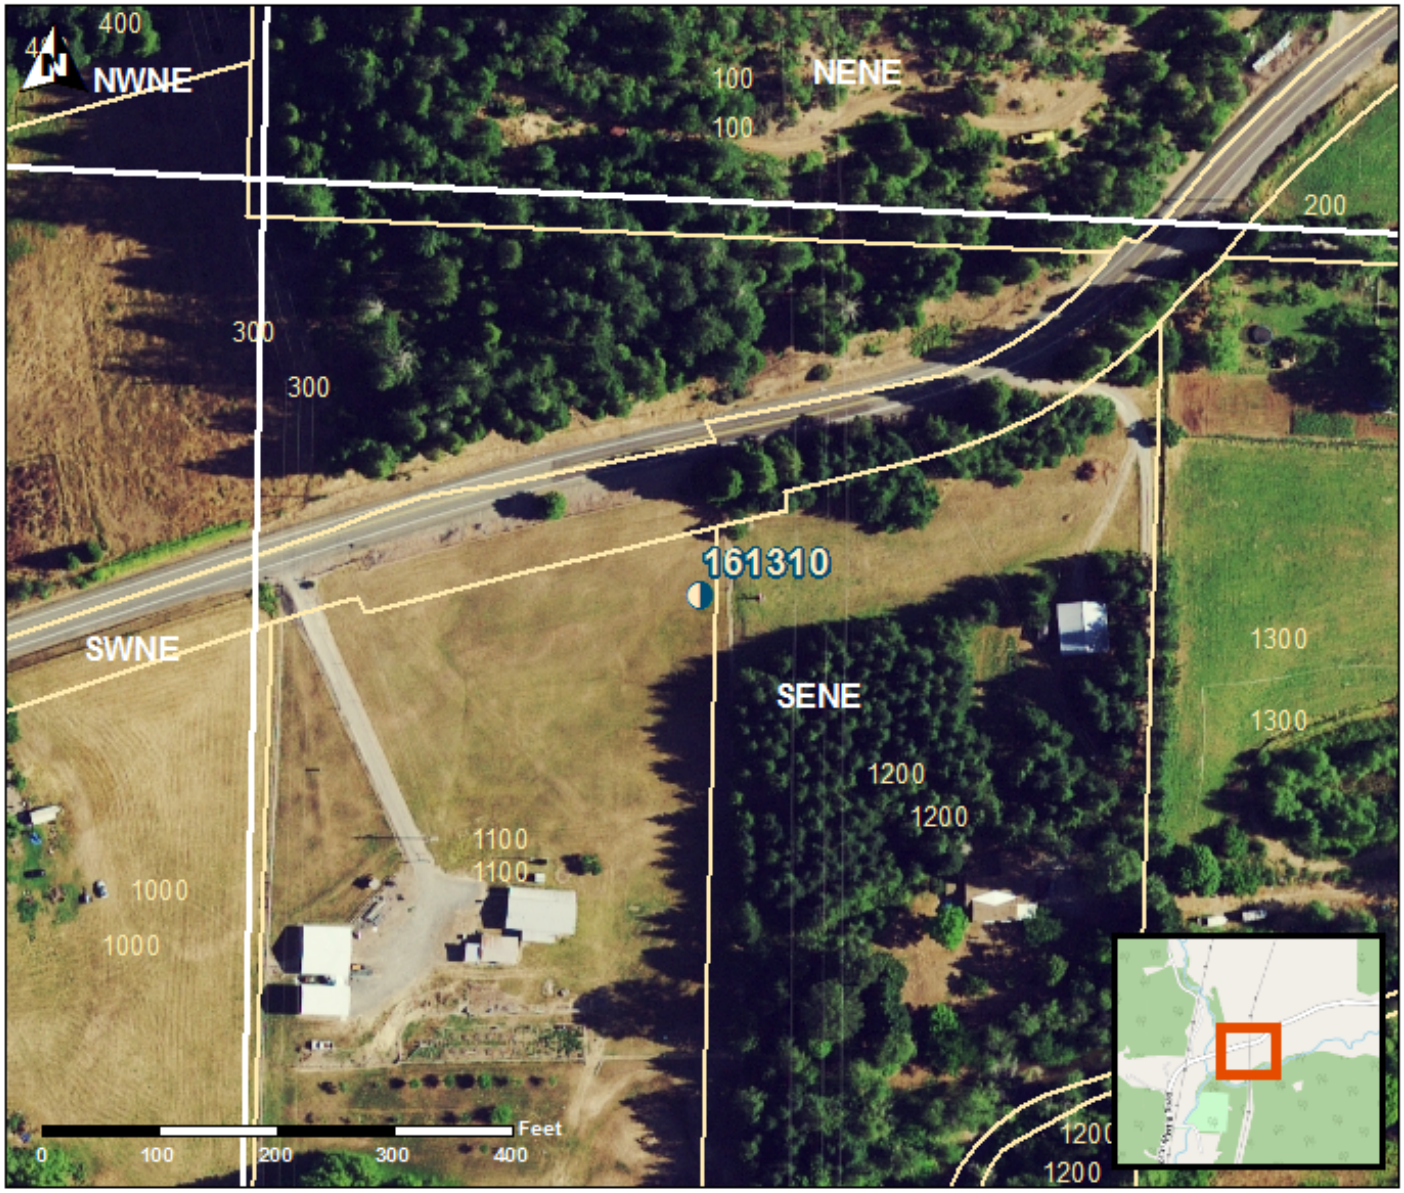
Provided by well constructor