

STATE ENGINEER
Salem, Oregon

DOUG

Well Record

STATE WELL NO. 27/6W-9D
COUNTY DOUGLAS
APPLICATION NO. GR-2301

006254

OWNER: Peta Veestra


MAILING ADDRESS: Rt 1 Box 555

LOCATION OF WELL: Owner's No. 1

CITY AND STATE:

NW 1/4 NW 1/4 Sec. 9 T. 27 S., R. 6 W., W.M.

Bearing and distance from section or subdivision corner 1584'W & 90' S of SW cor DLC # 50

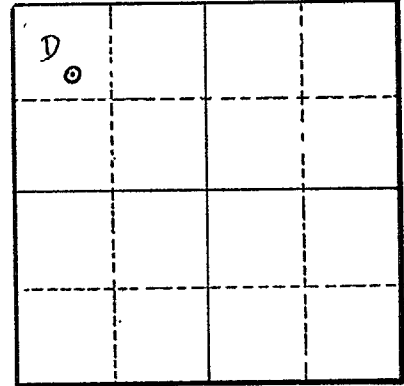

Section 9

Altitude at well

TYPE OF WELL: Drilled Date Constructed 1949

Depth drilled 60' Depth cased

CASING RECORD:

FINISH:

AQUIFERS:

WATER LEVEL:

30'

PUMPING EQUIPMENT: Type Berkley Deep Well Pump H.P. 1 1/2
Capacity 25 G.P.M.

WELL TESTS:

Drawdown _____ ft. after _____ hours _____ G.P.M.
Drawdown _____ ft. after _____ hours _____ G.P.M.

USE OF WATER Irrigation Temp. _____ °F. _____, 19_____

SOURCE OF INFORMATION GR-3899

DRILLER or DIGGER Earl Preschern

ADDITIONAL DATA:

Log NA Water Level Measurements _____ Chemical Analysis _____ Aquifer Test _____

REMARKS: