

STATE ENGINEER
Salem, Oregon

DOUG Well Record

016255

STATE WELL NO. 27/619D
COUNTY DOUGLAS
APPLICATION NO. GR-2302

OWNER: Pete Veenstra


MAILING ADDRESS Rt 3, Box 555

LOCATION OF WELL: Owner's No. 2

CITY AND STATE: Oregon

NW 1/4 NW 1/4 Sec. 9 T. 27 S., R. 6 W., W.M.

Bearing and distance from section or subdivision corner 1030' W & 40'S of Int cor W boundary DLC 50

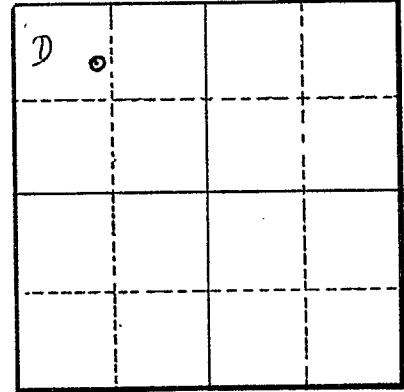

Section 9

Altitude at well _____

TYPE OF WELL: Drilled Date Constructed 1952

Depth drilled 60' Depth cased _____

CASING RECORD:

FINISH:

AQUIFERS:

WATER LEVEL: 30'

PUMPING EQUIPMENT: Type Berkley Deep well Pump H.P. 1 1/2
Capacity 35 G.P.M.

WELL TESTS:

Drawdown _____ ft. after _____ hours _____ G.P.M.
Drawdown _____ ft. after _____ hours _____ G.P.M.

USE OF WATER Irrigation Temp. _____ °F. _____, 19_____

SOURCE OF INFORMATION GR-3900

DRILLER or DIGGER Earl Preschern

ADDITIONAL DATA:

Log NA Water Level Measurements _____ Chemical Analysis _____ Aquifer Test _____

REMARKS: