

STATE ENGINEER
Salem, Oregon

DOG Well Record

STATE WELL NO. 26/6W-19
COUNTY DOUGLAS
APPLICATION NO. GR-2680

006581

OWNER: Sigvald Madson

MAILING
ADDRESS:

Rt. 2, Box 952


LOCATION OF WELL: Owner's No.

CITY AND
STATE:

Roseburg, Oregon

1/4 1/4 Sec. 19 T. 26 N. S., R. 6 W., W.M.

Bearing and distance from section or subdivision
corner N. 330' E. 150'

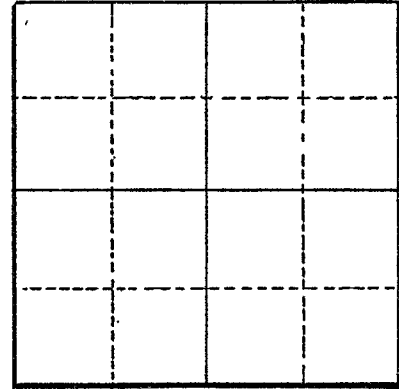

Section

Altitude at well

TYPE OF WELL: drilled Date Constructed 1948

Depth drilled 28 Depth cased 28

CASING RECORD:

6-inch

FINISH:

AQUIFERS:

loam soil, sand and gravel

WATER LEVEL:

14-feet

PUMPING EQUIPMENT: Type Deming H.P. 3
Capacity 70 G.P.M.

WELL TESTS:

Drawdown 2 ft. after hours Pumping 70 G.P.M.
Drawdown ft. after hours G.P.M.

USE OF WATER irrigation Temp. °F. 19

SOURCE OF INFORMATION GR-2537

DRILLER or DIGGER

ADDITIONAL DATA:

Log ^X Water Level Measurements Chemical Analysis Aquifer Test

REMARKS:

Loam soil 12
Sand 3
Gravel 13