

STATE ENGINEER
Salem, Oregon

DOUG

Well Record

STATE WELL NO. 26/6W-19K
COUNTY Douglas
APPLICATION NO. GR-1745

GR- 1692

006596

OWNER: Doris Moore

MAILING

ADDRESS: 1863 SE Douglas Ave.


LOCATION OF WELL: Owner's No.

CITY AND

STATE: Roseburg, Oregon

NW 1/4 SE 1/4 Sec. 19 T. 26 S, R. 6 W., W.M.

Bearing and distance from section or subdivision
corner 1980' N. & 1720' W. from SE cor. Sec. 19

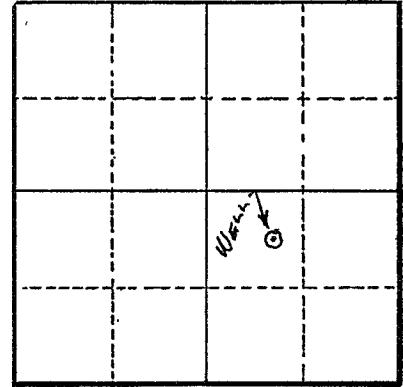

Section 19

Altitude at well

TYPE OF WELL: Drilled Date Constructed 1951

Depth drilled 30 Depth cased 24'

CASING RECORD:

6"

FINISH:

AQUIFERS:

WATER LEVEL:

20 to 25 ft.

PUMPING EQUIPMENT: Type Pacific 1 1/2" Cent. H.P. 3
Capacity 30 G.P.M.

WELL TESTS:

Drawdown 5 ft. after 30 hours G.P.M.

Drawdown ft. after hours G.P.M.

USE OF WATER Irrigation Temp. °F., 19

SOURCE OF INFORMATION GR Record

DRILLER or DIGGER

ADDITIONAL DATA:

Log N.A. Water Level Measurements Chemical Analysis Aquifer Test

REMARKS:

Irrigation of 5 acres.