

STATE ENGINEER
Salem, Oregon

DOUG Well Record

STATE WELL NO. 26/6W-19K
COUNTY Douglas
APPLICATION NO. GR-1668

006597 GR- 1619

OWNER: Myron O. Lehne


MAILING ADDRESS: Rt. 2, Box 953

LOCATION OF WELL: Owner's No.

CITY AND STATE: Roseburg, Oregon

NW ¼ SE ¼ Sec. 19 T. 26 S., R. 6 W., W.M.

Bearing and distance from section or subdivision
corner 2460' W. & 2300' N. from SE cor. Sec. 19

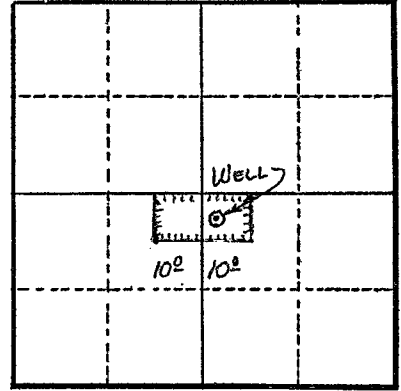

Section 19

Altitude at well 500'

TYPE OF WELL: Dug & Drill'd Date Constructed 1946

Depth drilled 29' Depth cased 29'

CASING RECORD:

Dug - 4' x 6' from 0 to 10 ft.
Drilled - 6" from 10 to 29 ft. (Steel casing)

FINISH:

AQUIFERS:

WATER LEVEL:

12'

PUMPING EQUIPMENT: Type Myers 1 1/2" Cent. H.P. 5
Capacity 150 G.P.M.

WELL TESTS:

Drawdown 4 ft. after 80 hours G.P.M.
Drawdown ft. after hours G.P.M.

USE OF WATER Irrigation Temp. °F., 19

SOURCE OF INFORMATION GR Record

DRILLER or DIGGER

ADDITIONAL DATA:

Log Water Level Measurements Chemical Analysis Aquifer Test

REMARKS:

Log: Sandy loam with some water below 12' 0 to 19 ft.
Sand - water bearing 19 to 22 ft.
Gravel - water bearing 22 to 29 ft.

Irrigation of 20 acres.