

STATE ENGINEER
Salem, Oregon

DOUG Well Record
006598

STATE WELL NO. 266W-19M
COUNTY DOUGLAS
APPLICATION NO. GR-2203

OWNER: Henry F. Hebard


MAILING ADDRESS: Rt. 2, Box 965

LOCATION OF WELL: Owner's No. _____

CITY AND STATE: Roseburg, Oregon

NW $\frac{1}{4}$ SW $\frac{1}{4}$ Sec. 19 T. 26 N. S., R. 6 E. W., W.M.

Bearing and distance from section or subdivision corner 350' N. and 98' W.

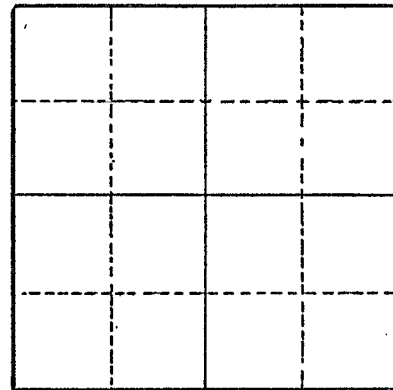

Section _____

Altitude at well _____

TYPE OF WELL: Drilled Date Constructed 1950

Depth drilled 50 Depth cased 30

CASING RECORD:

6-Inch

FINISH:

AQUIFERS:

Gravel and rock

WATER LEVEL:

15-Feet

PUMPING EQUIPMENT: Type Berkley Jet H.P. 3
Capacity 60 G.P.M.

WELL TESTS:

Drawdown _____ ft. after _____ hours _____ G.P.M.
Drawdown _____ ft. after _____ hours _____ G.P.M.

USE OF WATER Irrigation Temp. _____ °F., 19 _____

SOURCE OF INFORMATION GR-2108

DRILLER or DIGGER _____

ADDITIONAL DATA:

Log Water Level Measurements _____ Chemical Analysis _____ Aquifer Test _____

REMARKS:

River bottom loam 15 50
Gravel 15 35
Rock 20 20