

STATE ENGINEER
Salem, Oregon

DOUG Well Record

006599

STATE WELL NO. 26/6W-19R
COUNTY DOUGLAS
APPLICATION NO. GR-2170

OWNER: Nr, & Mrs. Carl Schmidt


MAILING ADDRESS: Rt 2 Box 900

LOCATION OF WELL: Owner's No. _____

CITY AND STATE: Roseburg, Oregon

SE 1/4 SE 1/4 Sec. 19 T. 26 S., R. 6 W., W.M.

Bearing and distance from section or subdivision corner 1000' N & 150 W from SE cor of Sec 19

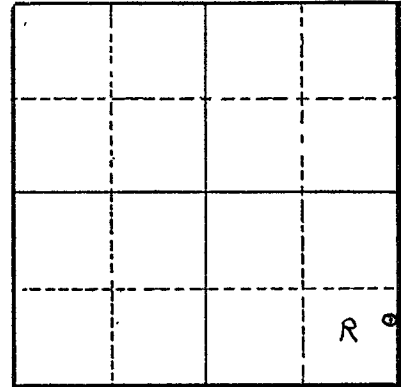

Section 19

Altitude at well _____

TYPE OF WELL: Dug Date Constructed 1945

Depth drilled 14' Depth cased _____

CASING RECORD:

FINISH:

AQUIFERS:

WATER LEVEL:

76'

PUMPING EQUIPMENT: Type Pacific Iron Works Pump H.P. 3
Capacity 30 G.P.M.

WELL TESTS:

Drawdown _____ ft. after _____ hours _____ G.P.M.
Drawdown _____ ft. after _____ hours _____ G.P.M.

USE OF WATER Irrigation Temp. _____ °F. _____, 19_____

SOURCE OF INFORMATION GR-3938

DRILLER or DIGGER _____

ADDITIONAL DATA:

Log NA Water Level Measurements _____ Chemical Analysis _____ Aquifer Test _____

REMARKS: