

STATE ENGINEER  
Salem, Oregon

**DOUG 7762**  
**DOUG Well Record**  
**007762**

STATE WELL NO. 28/6W-28C  
COUNTY Douglas  
APPLICATION NO. GR-3118

OWNER: Levi M. Gourley


MAILING ADDRESS: C. V. Route Box 710

LOCATION OF WELL: Owner's No. \_\_\_\_\_

CITY AND STATE: Winston, Oregon

NE 1/4 NW 1/4 Sec. 28 T. 28 N S, R. 6 E W., W.M.

Bearing and distance from section or subdivision  
corner 450' E. on N. Line from NW Corner of Lot 13  
Miller Subdivision

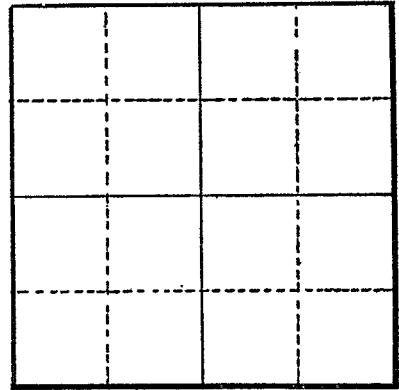

Section \_\_\_\_\_

Altitude at well \_\_\_\_\_

TYPE OF WELL: Dug Date Constructed 1952

Depth drilled 20' Depth cased 20'

CASING RECORD:  
23"

FINISH:

AQUIFERS:

Sandy Loam Soil, Gravel, Bed Rock

WATER LEVEL:  
8'

PUMPING EQUIPMENT: Type Pacific 1 1/2" Electric H.P. 2  
Capacity 50 G.P.M.

WELL TESTS:  
Drawdown 4 ft. after \_\_\_\_\_ hours pumping 75 G.P.M.  
Drawdown \_\_\_\_\_ ft. after \_\_\_\_\_ hours \_\_\_\_\_ G.P.M.

USE OF WATER Irrigation Temp. \_\_\_\_\_ °F., 19

SOURCE OF INFORMATION GR-2926

DRILLER or DIGGER \_\_\_\_\_

ADDITIONAL DATA:

Log X Water Level Measurements \_\_\_\_\_ Chemical Analysis \_\_\_\_\_ Aquifer Test \_\_\_\_\_

REMARKS:

Sandy Loam Soil      12    20  
Gravel                    8     20  
Bed Rock                 20