

DOUG 7774


STATE ENGINEER
Salem, Oregon

DOUG Well Record
007774 GR-928

STATE WELL NO. 28/6W-29B(1)
COUNTY Douglas
APPLICATION NO. GR-957

OWNER: Lawrence A. Hercher
MAILING ADDRESS: Box 14
CITY AND STATE: Dillard, Oregon

LOCATION OF WELL: Owner's No. _____
NW 1/4 NE 1/4 Sec. 29 T. 28 S., R. 6 W., W.M.
Bearing and distance from section or subdivision
corner 36 rods E. & 85 rods N. of Center of sec. 29.

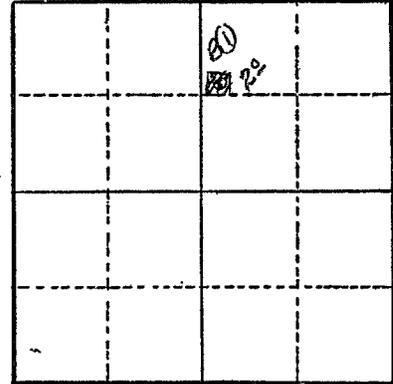

Section 29

Altitude at well 525 ft.

TYPE OF WELL: Dug Date Constructed 1925

Depth drilled 21.5 ft. Depth cased _____

CASING RECORD:

40 inch

FINISH:

AQUIFERS:

WATER LEVEL:

17 ft.

PUMPING EQUIPMENT: Type Berkeley shallow well H.P. 1

Capacity 30 G.P.M.

WELL TESTS:

Drawdown 1 ft. after _____ hours 25 G.P.M.

Drawdown _____ ft. after _____ hours _____ G.P.M.

USE OF WATER Irrigation Temp. _____ °F., 19

SOURCE OF INFORMATION G.R. Record

DRILLER or DIGGER _____

ADDITIONAL DATA:

Log _____ Water Level Measurements _____ Chemical Analysis _____ Aquifer Test _____

REMARKS:

Log: Sandy loam 0 to 13 ft.
River gravel 13 to 21.5 ft.

Irrigation of 2 acres.