

STATE ENGINEER
Salem, Oregon

DOUG
008497

Well Record

STATE WELL NO. 29/5W-32
COUNTY DOUGLAS
APPLICATION NO. GR-2875

OWNER: C. R. Weaver

MAILING ADDRESS: Myrtle Creek, Oregon


LOCATION OF WELL: Owner's No. #1

CITY AND STATE:

NE 1/4 SW 1/4 Sec. 32 T. 29 S., R. 5 E., W.M.

Bearing and distance from section or subdivision

corner N. 1287.9' W. 2584.4' N. 42° 40' W. 371' and
N. 47° 20' E. 126' from SW cor. Henry Adams DLC No. 42

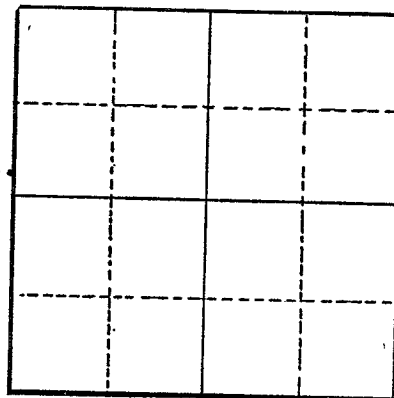

Section

Altitude at well

TYPE OF WELL: dug Date Constructed 1952

Depth drilled 21 Depth cased 21

CASING RECORD:

36-inch

FINISH:

AQUIFERS:

Loam and gravel

WATER LEVEL:

15-feet

PUMPING EQUIPMENT: Type Centrifugal Universal

Capacity 150 G.P.M. H.P. 5

WELL TESTS:

Drawdown ft. after hours G.P.M.

Drawdown ft. after hours G.P.M.

USE OF WATER irrigation Temp. °F., 19

SOURCE OF INFORMATION GR-2709

DRILLER or DIGGER By applicant

ADDITIONAL DATA:

Log Water Level Measurements Chemical Analysis Aquifer Test

REMARKS:

River bottom loam 18 3
Gravel 3