

STATE ENGINEER
Salem, Oregon

DOUG
008498

Well Record

STATE WELL NO. 29/5W-32N
COUNTY Douglas
APPLICATION NO. GR-3928

OWNER: George D. Weaver

MAILING ADDRESS: Myrtle Creek,


LOCATION OF WELL: Owner's No.

CITY AND STATE: Oregon

SW 1/4 SW 1/4 Sec. 32 T. 29 S., R. 5 W., W.M.

Bearing and distance from section or subdivision

corner 1300' E. & 1250' N. from SW Cor. Sec. 32

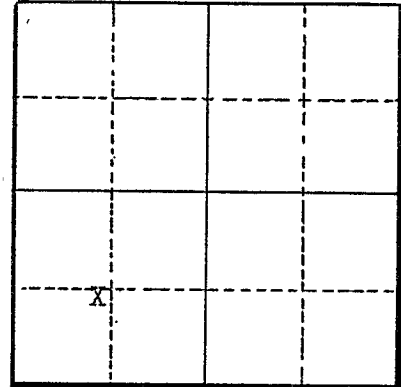

Altitude at well

TYPE OF WELL: Dug Date Constructed 1947

Depth drilled 26 ft. Depth cased

CASING RECORD:

30 inch diameter, 36 inch outside dimension

FINISH:

AQUIFERS:

WATER LEVEL:

20 feet below surface

PUMPING EQUIPMENT: Type electric H.P. 3/4
Capacity 500 G.P.M.

WELL TESTS:

Drawdown ft. after hours G.P.M.

Drawdown ft. after hours G.P.M.

USE OF WATER Irrigation Temp. °F. 19

SOURCE OF INFORMATION Well Registration Statement Cert. # GR-3563

DRILLER or DIGGER

ADDITIONAL DATA:

Log Water Level Measurements Chemical Analysis Aquifer Test

REMARKS: