

DOUG 8611

STATE ENGINEER
Salem, Oregon

DOUG
008611

Well Record

STATE WELL NO. 29/6W-12F
COUNTY Douglas
APPLICATION NO.

OWNER: A. H. Helgeson

MAILING
ADDRESS:

LOCATION OF WELL: Owner's No.


CITY AND
STATE:

Myrtle Creek, Oregon

SE 1/4 NW 1/4 Sec. 12 T. 29 S. R. 6 W., W.M.

Bearing and distance from section or subdivision

corner 1830' E & 2730' N of SW cor. sec. 12.

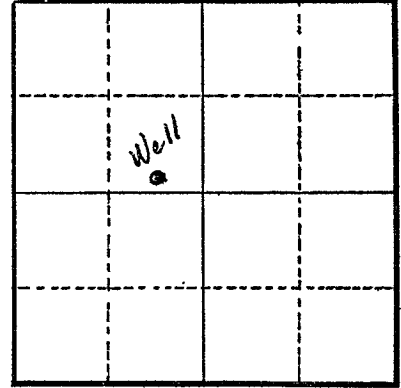

Section 12

Altitude at well

TYPE OF WELL: Dug Date Constructed 1952

Depth drilled 21 ft. Depth cased 21 ft.

CASING RECORD:

42 inch

FINISH:

AQUIFERS:

WATER LEVEL:

18 ft.

PUMPING EQUIPMENT: Type Advance Jet

H.P. 5

Capacity 90 G.P.M.

WELL TESTS:

Drawdown None ft. after hours 43.3 G.P.M.

Drawdown ft. after hours G.P.M.

USE OF WATER Domestic Temp. °F. 19.

SOURCE OF INFORMATION Related registration statement

DRILLER or DIGGER A. H. Helgesen

ADDITIONAL DATA:

Log Water Level Measurements Chemical Analysis Aquifer Test

REMARKS:

Log: Black loam 0' to 18'
Gravel (water) 18' to 21'



Oregon Water Resources Department
725 Summer Street NE, Suite A
Salem Oregon 97301
(503) 986-0900
www.wrd.state.or.us

Application for
Well ID Number

RECEIVED

OCT 01 2015

WATER RESOURCES DEPT
SALEM, OREGON

Do not complete if the well already has a Well Identification Number.

I. OWNER INFORMATION

Current Owner Name (please print): AL HELGESON
Mailing Address: 15892 OLD HWY 99 S
City, State, Zip: MYRTLE CREEK, OR 97457
Mail Well ID Tag to: [X] SAME AS ABOVE [] In Care Of (C/O)
Name & Address:
City, State, Zip:

II. WELL LOCATION INFORMATION (Please fill out as completely as possible)

Township: 29 S (North / South) Range: 6 W (East / West) Section: 12 F
Tax Lot: 1300 County DOUGLAS SE 1/4 OF NW 1/4
GPS Coordinates: 1830' E & 2730' N OF SW COR SEC 12
Street Address of Well, City: 15892 OLD HWY 99 S
If the property had a different street address in the past:

III. GENERAL WELL INFORMATION (Please fill out as completely as possible)

Use of Well (domestic, irrigation, commercial, industrial, monitoring): DOMESTIC
Date Well Constructed (or property built): 1952 Total Well Depth: 21 Casing Diameter: 42"
Owner at time the well was constructed (if known): AL HELGESON
Other Information:

SUBMITTED BY (please print): AL HELGESON
PHONE: 541-863-5541 EMAIL &/or FAX:

Send application to: Oregon Water Resources Department 725 Summer St NE, Suite A, Salem, Oregon 97301; or fax to (503) 986-0902. Applications are processed in the order they are received, and Well ID Numbers are mailed within 4-5 business days.

For Official Use Only by the Oregon Water Resources Department:

Received Date:

10-1-15

{over phone}

Well Log Number:

DOUG 8611

Well Identification #:

L-120414