

DOUG 9212

STATE ENGINEER
Salem, Oregon

DOUG Well Record

STATE WELL NO. 30/5W - 7A
COUNTY DOUGLAS
APPLICATION NO. GR-2133

009212

OWNER: Tri-City Drive-In, Inc.


MAILING ADDRESS: Myrtle Creek,

LOCATION OF WELL: Owner's No.

CITY AND STATE: Oregon

NE 1/4 NE 1/4 Sec. 7 T. 30 N. S. R. 5 W., W.M.

Bearing and distance from section or subdivision corner 1150'E. 1110.0' from well

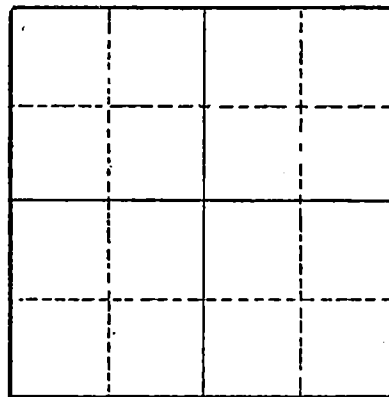

Section

Altitude at well

TYPE OF WELL: Drilled Date Constructed 1953

Depth drilled 55 Depth cased 50

CASING RECORD:

8-Inch

FINISH:

AQUIFERS:

Clay and rock

WATER LEVEL:

20-feet

PUMPING EQUIPMENT: Type Jacuzzi Centrifugal pump H.P. 1 1/2
Capacity 120 G.P.M.

WELL TESTS:

Drawdown 0 ft. after hours Pumping 200 G.P.M.

Drawdown ft. after hours G.P.M.

USE OF WATER Irrigation Temp. °F., 19

SOURCE OF INFORMATION GR-2046

DRILLER or DIGGER

ADDITIONAL DATA:

Log X Water Level Measurements Chemical Analysis Aquifer Test

REMARKS:

Gravelly clay 53 53
Bed rock — 5'