

STATE ENGINEER
Salem, Oregon

DOUG DOUG 9390
DOUG Well Record
009390

STATE WELL NO. 30/5W-34D
COUNTY DOUGLAS
~~APPLICATION NO.~~ GR-2818

OWNER: George H. Barrow

MAILING ADDRESS:

P. O. Box 731

LOCATION OF WELL: Owner's No. _____


CITY AND STATE:

Canyonville, Oregon

NW 1/4 NW 1/4 Sec. 34 T. 30 ~~N.~~ 5 ~~E.~~
S., R. W., W.M.

Bearing and distance from section or subdivision

corner N. 6° W. 368'

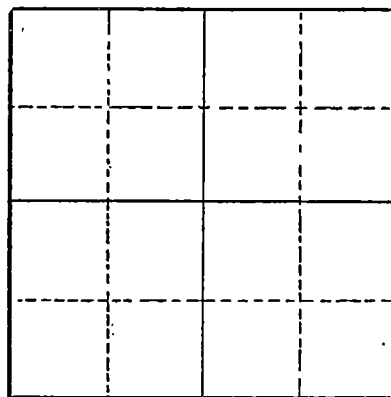

Section _____

Altitude at well _____

TYPE OF WELL: dug Date Constructed _____

Depth drilled 8 Depth cased 8

CASING RECORD:

36-inch

FINISH:

AQUIFERS:

WATER LEVEL:

3-feet

PUMPING EQUIPMENT: Type Fairway H.P. 1/4
Capacity 400 G.P.M.

WELL TESTS:

Drawdown _____ ft. after _____ hours _____ G.P.M.

Drawdown _____ ft. after _____ hours _____ G.P.M.

USE OF WATER irrigation Temp. _____ °F., 19 _____

SOURCE OF INFORMATION GR-2659

DRILLER or DIGGER _____

ADDITIONAL DATA:

Log _____ Water Level Measurements _____ Chemical Analysis _____ Aquifer Test _____

REMARKS: