

STATE ENGINEER
Salem, Oregon

DOUG
009418

DOUG 9418
Well Record

STATE WELL NO. 30/6W-24K
COUNTY DOUGLAS
APPLICATION NO. GR-2360


OWNER: Mayme E. Carter (a widow)

MAILING ADDRESS: Rt. 1, Box 107

LOCATION OF WELL: Owner's No. #1

CITY AND STATE: Riddle, Oregon

NW 1/4 SE 1/4 Sec. 24 T. 30 S., R. 6 W., W.M.

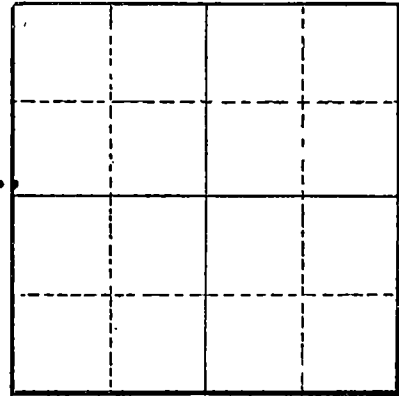

Bearing and distance from section or subdivision

corner Beginning at a point 3.41 chains S. from the SE

corner of the J.Q.C. Vanderbosch D.L.C. No. 47 T. 30S.

R. 6 W., W.M. Thence S. 73° E. 436'

Altitude at well

TYPE OF WELL: Dug Date Constructed 1924

Depth drilled 11 Depth cased 9

Section

CASING RECORD:

6-inch

FINISH:

AQUIFERS:

Topsoil and gravel

WATER LEVEL:

8-feet

PUMPING EQUIPMENT: Type Berkley Centrifugal H.P. 3
Capacity 78 G.P.M.

WELL TESTS:

Drawdown ft. after hours Pumping 80 G.P.M.

Drawdown ft. after hours G.P.M.

USE OF WATER Irrigation Temp. °F., 19

SOURCE OF INFORMATION GR-2242

DRILLER or DIGGER

ADDITIONAL DATA:

Log Water Level Measurements Chemical Analysis Aquifer Test

REMARKS:

Topsoil 1'
Gravel 10'