

STATE ENGINEER
Salem, Oregon

DOUG **DOUG 9419**
Well Record
009419

STATE WELL NO. 30/6W-24K
COUNTY DOUGLAS
APPLICATION NO. GR-2361


OWNER: Mayme E. Carter (a widow)

MAILING ADDRESS: Rt. 1, Box 107

LOCATION OF WELL: Owner's No. _____

CITY AND STATE: Riddle, Oregon

NW 1/4 SE 1/4 Sec. 24 T. 30 N S., R. 6 W., W.M.

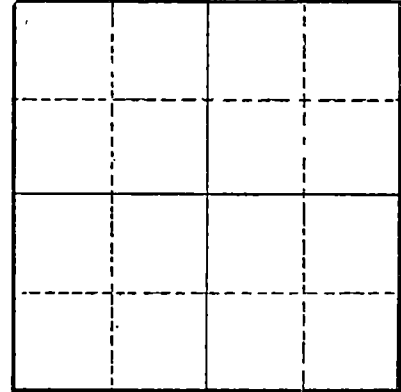

Bearing and distance from section or subdivision corner Beginning at a point 3.41 chains S. from the J.Q.C. Vanderbosch D.L.C. No. 47 T. 30 S., R. 6 W., W.M., Thence S. 1° E. 420'

Altitude at well _____

TYPE OF WELL: Dug Date Constructed 1951

Depth drilled 15 Depth cased 15

Section _____

CASING RECORD:

30-inch

FINISH:

AQUIFERS:

Gravel

WATER LEVEL:

12-feet

PUMPING EQUIPMENT: Type Pacific V. Belt Drive Centrifugal H.P. 5
Capacity 120 G.P.M.

WELL TESTS:

Drawdown 2 ft. after _____ hours Pumping 120 G.P.M.

Drawdown _____ ft. after _____ hours _____ G.P.M.

USE OF WATER Irrigation Temp. _____ °F., 19

SOURCE OF INFORMATION GR-2243

DRILLER or DIGGER _____

ADDITIONAL DATA:

Log X Water Level Measurements _____ Chemical Analysis _____ Aquifer Test _____

REMARKS:

Gravel 15' 15'