

STATE ENGINEER  
Salem, Oregon

**DOUG 9421**  
**DOUG Well Record**  
**009421**

STATE WELL NO. 30/6W-24P  
COUNTY DOUGLAS  
APPLICATION NO. GR-2362

OWNER: Darrel Carter


MAILING ADDRESS: P. O. Box 155

LOCATION OF WELL: Owner's No. \_\_\_\_\_

CITY AND STATE: Riddle, Oregon

SE ¼ SW ¼ Sec. 24 T. 30 S., R. 6 W., W.M.

Bearing and distance from section or subdivision  
corner N. 21° 41' E. 2128.0' thence N. 71° 56' E. 696'  
to well.

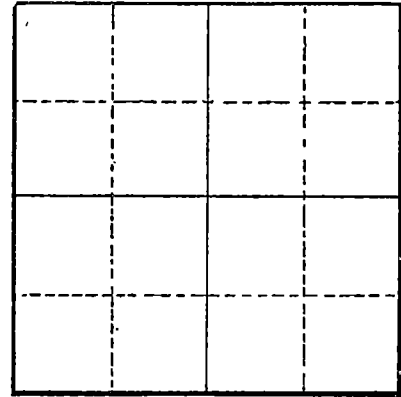

Section \_\_\_\_\_

Altitude at well \_\_\_\_\_

TYPE OF WELL: Dug Date Constructed 1943

Depth drilled 12 Depth cased 10 & 12

CASING RECORD:

8-inch  
2' x 2' x 5'

FINISH:

AQUIFERS:

Topsoil and gravel

WATER LEVEL:

9-feet

PUMPING EQUIPMENT: Type Berkley Centrifugal H.P. 3  
Capacity 88 G.P.M.

WELL TESTS:

Drawdown \_\_\_\_\_ ft. after \_\_\_\_\_ hours Pumping 80 G.P.M.  
Drawdown 2 ft. after \_\_\_\_\_ hours Pumping 120 G.P.M.

USE OF WATER Irrigation Temp. \_\_\_\_\_ °F., 19 \_\_\_\_\_

SOURCE OF INFORMATION GR-2244

DRILLER or DIGGER \_\_\_\_\_

ADDITIONAL DATA:

Log X Water Level Measurements \_\_\_\_\_ Chemical Analysis \_\_\_\_\_ Aquifer Test \_\_\_\_\_

REMARKS:

Topsoil 1½' 10½'  
Gravel 10½' Bottom of well