

STATE ENGINEER
Salem, Oregon

DOUG DOUG 9422
Well Record
009422


STATE WELL NO. 30/6W-24R...
COUNTY Douglas...
APPLICATION NO. GR-3161...

OWNER: Rudolph E. Paetz MAILING ADDRESS: Route 1, Box 103

LOCATION OF WELL: Owner's No. CITY AND STATE: Riddle, Oregon

SE 1/4 SE 1/4 Sec. 24 T. 30 N. S, R. 6 E. W., W.M.

Bearing and distance from section or subdivision
corner .620 feet West and .555 feet North from the SE Corner,
Section 24.

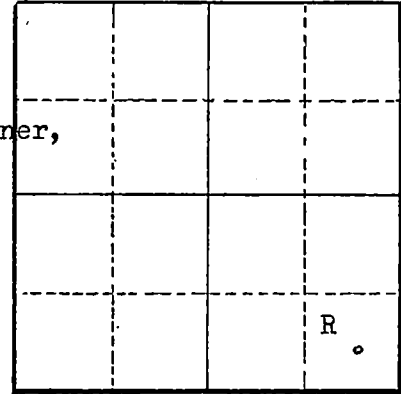

Section 24

Altitude at well 700 feet

TYPE OF WELL: Dug Date Constructed Aug. '54

Depth drilled 12 feet Depth cased 12 feet

CASING RECORD:

60-inch square casing set from surface to 12 feet

FINISH:

AQUIFERS:

sand and gravel

WATER LEVEL:

7 feet

PUMPING EQUIPMENT: Type Berkeley Centrifugal 1 1/2 x 2 H.P.
Capacity G.P.M.

WELL TESTS:

Drawdown 4 ft. after 800 gph G.P.M.
Drawdown ft. after hours G.P.M.

USE OF WATER Irrigation Temp. °F., 19

SOURCE OF INFORMATION GR-4058

DRILLER or DIGGER self dug well

ADDITIONAL DATA:

Log x Water Level Measurements Chemical Analysis Aquifer Test

REMARKS:

top soil 0 2 2
sand and gravel 2 7 5
water bearing blue sand 2
gravel 2
bed rock 1