

DOUG 9423


STATE ENGINEER  
Salem, Oregon

DOUG Well Record  
009423

STATE WELL NO. 30/6W-24R  
COUNTY Douglas  
APPLICATION NO. GR-4121

OWNER: Herbert W. Hard  
MAILING ADDRESS: Route 1, Box 104  
CITY AND STATE: Riddle, Oregon

LOCATION OF WELL: Owner's No.  
SE 1/4 SE 1/4 Sec. 24 T. 30 S. R. 6 W., W.M.  
Bearing and distance from section or subdivision  
corner 550' W. & 600' N. from SE Cor. Sec. 24

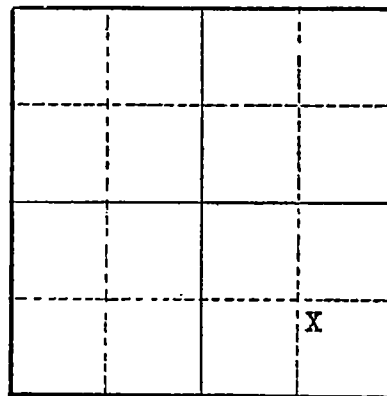

Altitude at well  
TYPE OF WELL: Dug Date Constructed 7/55  
Depth drilled 14 ft. Depth cased 14 ft.

Section 24

CASING RECORD:

24 inch reinforced cement culvert tile from 4 ft. above ground to 8 feet  
24 to 42 inches reinforced cement cone from 8 to 10 feet  
42 inches reinforced cement culvert tile from 10 to 14 feet

FINISH:

AQUIFERS:

WATER LEVEL:

7 feet below surface

PUMPING EQUIPMENT: Pacific Type Pace turbine type H.P. 1  
Capacity 13 1/3 G.P.M.

WELL TESTS:

Drawdown 13.1/3 ft. after 5 hours G.P.M.  
Drawdown ft. after hours G.P.M.

USE OF WATER Irrigation Temp. °F., 19

SOURCE OF INFORMATION Well Registration Statement Cert. # GR-3704

DRILLER or DIGGER

ADDITIONAL DATA:

Log Water Level Measurements Chemical Analysis Aquifer Test

REMARKS: