

DOUG 9435

STATE ENGINEER  
Salem, Oregon

DOUG Well Record  
009435

STATE WELL NO. 30/6W-26 L  
COUNTY DOUGLAS  
APPLICATION NO. GR-2520

OWNER: William E. Markham

MAILING ADDRESS:

LOCATION OF WELL: Owner's No.


CITY AND STATE:

Riddle, Oregon

NE 1/4 SW 1/4 Sec. 26 T. 30 S., R. 6 W., W.M.

Bearing and distance from section or subdivision

corner S. 15° W. 149.0' from the SE corner of the I. B. Nichols D.L.C. #44

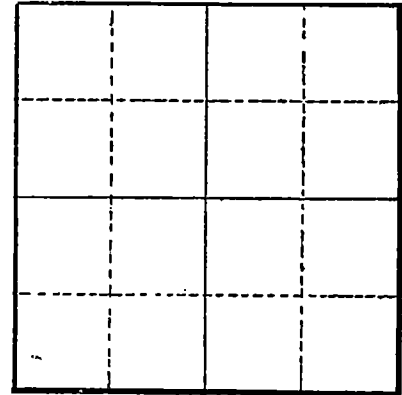

Section

Altitude at well

TYPE OF WELL: Dug Date Constructed 1953

Depth drilled Depth cased

CASING RECORD:

FINISH:

AQUIFERS:

Loam, clay, sand, gravel and rock

WATER LEVEL:

10-inch

PUMPING EQUIPMENT: Type Jacuzzi Centrifugal H.P. 1  
Capacity 300 G.P.M.

WELL TESTS:

Drawdown 3 ft. after hours Pumping 400 G.P.M.

Drawdown 1 ft. after hours Pumping 60 G.P.M.

USE OF WATER Irrigation Temp. °F., 19

SOURCE OF INFORMATION GR-2384

DRILLER or DIGGER

ADDITIONAL DATA:

Log X Water Level Measurements Chemical Analysis Aquifer Test

REMARKS:

- Sandy loam 2
- Clay 8
- Sand & gravel - water bearing 4
- Bed rock