

STATE ENGINEER  
Salem, Oregon

**DOUG 9705**  
**Well Record**  
DOUG  
009705

STATE WELL NO. 32/5W-19R  
COUNTY Douglas  
APPLICATION NO. GR-4058

OWNER: Hugh H. Morrell  
MAILING ADDRESS: Old Hwy. 99

LOCATION OF WELL: Owner's No. \_\_\_\_\_  
CITY AND STATE: Glendale, Oregon


SE 1/4 SE 1/4 Sec. 19 T. 32 N. S., R. 5 E. W., W.M.

Bearing and distance from section or subdivision  
corner 680' N. 55° W. from cor. of Sec. 19

Altitude at well \_\_\_\_\_

TYPE OF WELL: Drilled Date Constructed 4/27/55

Depth drilled 29 ft. Depth cased 29 ft.

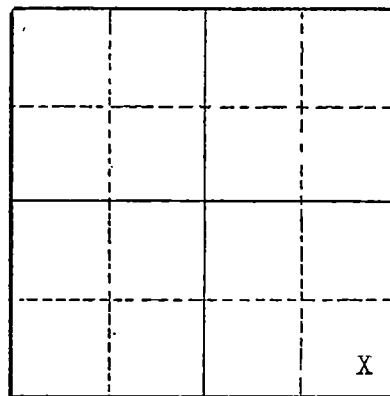

Section 19

CASING RECORD:

12 inch standard line pipe from 0 to 29 feet

FINISH:

1/4 inch slots, 16 slots per foot from 9 to 29 feet

AQUIFERS:

WATER LEVEL:

6.5 feet below surface

PUMPING EQUIPMENT: Type None at present time H.P. \_\_\_\_\_  
Capacity \_\_\_\_\_ G.P.M.

WELL TESTS:

Drawdown 12 ft. after \_\_\_\_\_ hours 75 G.P.M.  
Drawdown \_\_\_\_\_ ft. after \_\_\_\_\_ hours \_\_\_\_\_ G.P.M.

USE OF WATER Irrigation Temp. \_\_\_\_\_ °F. \_\_\_\_\_, 19

SOURCE OF INFORMATION Well Registration Statement Cert. # GR-3658

DRILLER or DIGGER Roy Coleman

ADDITIONAL DATA:

Log X Water Level Measurements \_\_\_\_\_ Chemical Analysis \_\_\_\_\_ Aquifer Test \_\_\_\_\_

REMARKS:

Log: Top & sub soil, Columbia series Thickness 5 Depth to Bottom 5  
Washed gravel & boulders 24 29