

STATE ENGINEER
Salem, Oregon

DOUG 9813
DOUG 009813
Well Record

STATE WELL NO. 32S/5W-30E
COUNTY DOUGLAS
APPLICATION NO. GR-2840

OWNER: Chester A. Smith, Jr.


MAILING ADDRESS: Glendale, Oregon

LOCATION OF WELL: Owner's No. _____

CITY AND STATE: _____

SW 1/4 NW 1/4 Sec. 30 T. 32 N. S., R. 5 E. W., W.M.

Bearing and distance from section or subdivision corner 1690.6' from 1/4 corner on west line of section 30, on a line bearing N. 39° 30'E.

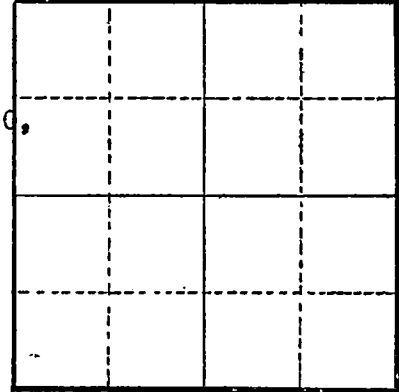

Section _____

Altitude at well _____

TYPE OF WELL: drilled Date Constructed 1955

Depth drilled 45 Depth cased 45

CASING RECORD:

12-feet

FINISH:

24 - 1/8 x 1 1/2 in. slots per foot from 6' to 45'

AQUIFERS:

Soil, sand and gravel

WATER LEVEL:

6.0-feet

PUMPING EQUIPMENT: Type Fairbanks Morse Centrifugal H.P. _____
Capacity _____ G.P.M.

WELL TESTS:

Drawdown 0.5 ft. after _____ hours _____ Pumping 70 G.P.M.
Drawdown 4.6 ft. after _____ hours _____ Pumping 240 G.P.M.

USE OF WATER Irrigation Temp. _____ °F., 19_____

SOURCE OF INFORMATION GR-2760

DRILLER or DIGGER _____

ADDITIONAL DATA:

Log Water Level Measurements _____ Chemical Analysis _____ Aquifer Test _____

REMARKS:

Top & sub soil, Columbia series loamy sand 6 6
Gravel w/some coarse sand, progressing
to washed boulders w/ some mixed
gravel at greater depth (all water bearing) 39 45