

STATE ENGINEER
Salem, Oregon

DOUG DOUG 9892
Well Record

009892

STATE WELL NO. 32/6N-32
COUNTY DOUGLAS
APPLICATION NO. GR-2633

OWNER: Harley A. Miller


MAILING ADDRESS: P. O. Box 195

LOCATION OF WELL: Owner's No.

CITY AND STATE: Glendale, Oregon

1/4 1/4 Sec. 32 T. 32 S., R. 6 W., W.M.

Bearing and distance from section or subdivision corner 950' W. and 720' N.

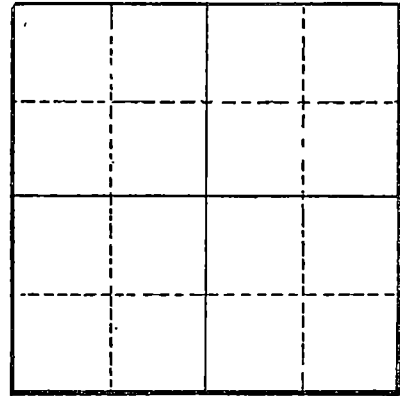

Section

Altitude at well

TYPE OF WELL: Drilled Date Constructed 1955

Depth drilled .65 Depth cased

CASING RECORD:

12-inch

FINISH:

1/4 x 3 - 24 perforations to the foot

AQUIFERS:

WATER LEVEL:

5-feet

PUMPING EQUIPMENT: Type Westinghouse Centrifugal H.P. 5

Capacity 100 G.P.M.

WELL TESTS:

Drawdown ft. after hours G.P.M.

Drawdown ft. after hours G.P.M.

USE OF WATER Irrigation Temp. °F., 19

SOURCE OF INFORMATION GR-2497

DRILLER or DIGGER Collman Well Drillers, Grants Pass, Oregon

ADDITIONAL DATA:

Log Water Level Measurements Chemical Analysis Aquifer Test

REMARKS: