

STATE ENGINEER  
Salem, Oregon

**DOUG 9943**  
**DOUG Well Record**  
**009943**


STATE WELL NO. 32/6W-35A  
COUNTY DOUGLAS  
APPLICATION NO. GR-3389

OWNER: William A. & Elizabeth M. Vaughn MAILING ADDRESS: Hwy N 99, Box 4

LOCATION OF WELL: Owner's No. \_\_\_\_\_ CITY AND STATE: Glendale, Oregon

NE 1/4 NE 1/4 Sec. 35 T. 32 S., R. 6 W., W.M.

Bearing and distance from section or subdivision corner 940' W & 790' S from NE cor Sec 35

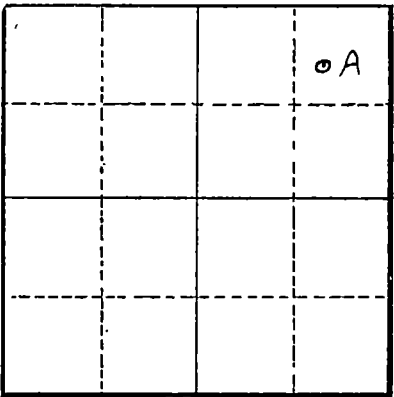

Section 35

Altitude at well \_\_\_\_\_

TYPE OF WELL: Drilled Date Constructed 1951

Depth drilled 53' Depth cased \_\_\_\_\_

CASING RECORD:

FINISH:

AQUIFERS:

Creek gravel

WATER LEVEL:

7'

PUMPING EQUIPMENT: Type Downward jet H.P. 3  
Capacity 75 G.P.M.

WELL TESTS:

Drawdown 30 ft. after \_\_\_\_\_ hours 70 G.P.M.

Drawdown \_\_\_\_\_ ft. after \_\_\_\_\_ hours \_\_\_\_\_ G.P.M.

USE OF WATER Irrigation Temp. \_\_\_\_\_ °F. \_\_\_\_\_, 19\_\_\_\_

SOURCE OF INFORMATION GR-3904

DRILLER or DIGGER Paquin & Story Well Drillers

ADDITIONAL DATA:

Log x Water Level Measurements \_\_\_\_\_ Chemical Analysis \_\_\_\_\_ Aquifer Test \_\_\_\_\_

REMARKS:

Creek gravel Unk