

STATE ENGINEER
Salem, Oregon

Gill
148

OBSERVATION WELL

Well Record

STATE WELL NO. *abc* 3N/21-34
COUNTY Gilliam
APPLICATION NO. U-685
Also App # G-3821

OWNER: Hulden Motor Co.

MAILING ADDRESS:

LOCATION OF WELL: Owner's No.


CITY AND STATE:

Arlington, Oregon

NW 1/4 NE 1/4 Sec. 34 T. 3 N. S. R. 21 E. W., W.M.

Bearing and distance from section or subdivision

corner S 75° 32' E 3084' from NW cor. Sec. 34

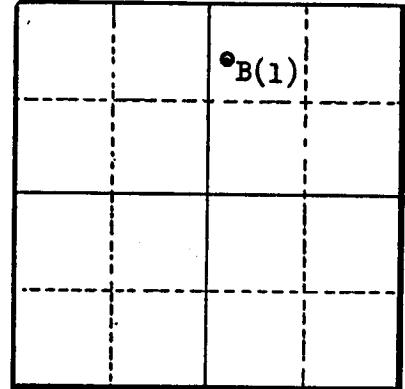

Section 34

Altitude at well

TYPE OF WELL: Drilled Date Constructed 53-54

Depth drilled 315 Depth cased

CASING RECORD:

12-inch

FINISH:

AQUIFERS:

WATER LEVEL:

250' below land surface 1954

PUMPING EQUIPMENT: Type Peerless

H.P.

Capacity 400 G.P.M.

WELL TESTS:

Drawdown ft. after hours G.P.M.

Drawdown ft. after hours G.P.M.

USE OF WATER Irrigation

Temp. °F., 19....

SOURCE OF INFORMATION

DRILLER or DIGGER

ADDITIONAL DATA:

Log Water Level Measurements Chemical Analysis Aquifer Test

REMARKS: