

STATE ENGINEER
Salem, Oregon


193
GILL

Well Record

STATE WELL NO. 3/21-19G
COUNTY Gilliam
APPLICATION NO. GR-3886

OWNER: Ernest Lear
Mayor of Condon on behalf of city
LOCATION OF WELL: Owner's No. _____
MAILING ADDRESS: _____
CITY AND STATE: Condon, Oregon

SW 1/4 NE 1/4 Sec. 19 T. 3 S. R. 21 E. W.M.
Bearing and distance from section or subdivision
corner 1600' S. & 2100' W. from NE Cor. Sec. 19.

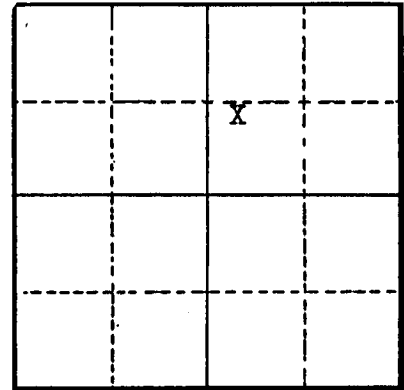

Section 19

Altitude at well _____
TYPE OF WELL: Drilled Date Constructed Mar. 1927
Depth drilled 65 feet Depth cased 50 feet

CASING RECORD:

6 inch casing set to 50 feet

FINISH:

AQUIFERS:

WATER LEVEL:

50 feet below surface

PUMPING EQUIPMENT: Type Piston H.P. Dissel
Capacity 100 G.P.M.

WELL TESTS:

Drawdown _____ ft. after _____ hours _____ G.P.M.
Drawdown _____ ft. after _____ hours _____ G.P.M.

USE OF WATER Municipal Temp. _____ °F., 19_____
SOURCE OF INFORMATION Well Registration Statement Cert. # GR-3532

DRILLER or DIGGER

ADDITIONAL DATA:

Log _____ Water Level Measurements _____ Chemical Analysis _____ Aquifer Test _____

REMARKS: