

GILL...203

Well Record

STATE WELL NO. 4/21
COUNTY Gilliam
APPLICATION NO.

OWNER: Condon Radar Base


MAILING ADDRESS:

LOCATION OF WELL: Owner's No. #1

CITY AND STATE:

..... 1/4 1/4 Sec. T. N. S, R. E. W., W.M.

Bearing and distance from section or subdivision corner

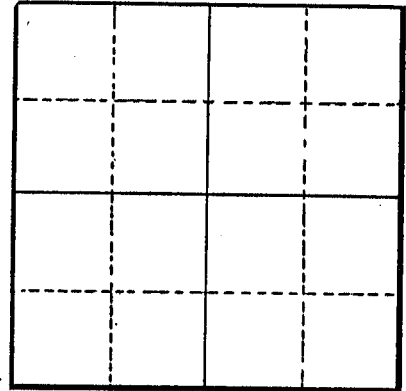

Section

Altitude at well

TYPE OF WELL: Drilled Date Constructed 12001

Depth drilled Depth cased

CASING RECORD:

FINISH:

AQUIFERS:

WATER LEVEL:

PUMPING EQUIPMENT: Type Capacity G.P.M. H.P.

WELL TESTS: Drawdown ft. after hours G.P.M. Drawdown ft. after hours G.P.M.

USE OF WATER Temp. °F. 19

SOURCE OF INFORMATION

DRILLER or DIGGER

ADDITIONAL DATA: Log Water Level Measurements Chemical Analysis Aquifer Test

REMARKS: