

STATE ENGINEER
Salem, Oregon

GILL. 204 Well Record

STATE WELL NO. 4/21-10D
COUNTY Gilliam
APPLICATION NO. GR-3882
Thru - 3886

OWNER: Ernest Lear
Mayor of Condon and on behalf of City
LOCATION OF WELL: Owner's No. CITY AND STATE: Condon, Oregon


NW 1/4 NW 1/4 Sec. 10 T. 4 S., R. 21 E., W.M.

Bearing and distance from section or subdivision
corner 100' S. & E. from the NW Cor. Sec. 10

Altitude at well

TYPE OF WELL: Drilled Date Constructed 1906

Depth drilled 410 ft. Depth cased 50 ft.

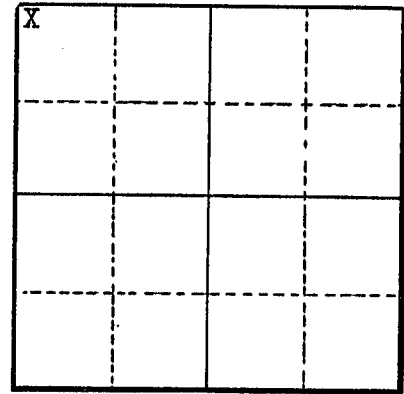

Section 10

CASING RECORD:

6 inch casing set to 50 feet

FINISH:

AQUIFERS:

WATER LEVEL:

50 feet below surface

PUMPING EQUIPMENT: Type None at present H.P.
Capacity G.P.M.

WELL TESTS:

Drawdown ft. after hours G.P.M.

Drawdown ft. after hours G.P.M.

USE OF WATER Municipal Temp. °F., 19

SOURCE OF INFORMATION Well Registration Statement Cert. # GR-3531

DRILLER or DIGGER

ADDITIONAL DATA:

Log Water Level Measurements Chemical Analysis Aquifer Test

REMARKS: