RECEIVED

GILL


STATE OF OREGON
ATER SUPPLY WELL REPORT

50000

MAY 1 7 1999

WELL I.D. #L 430737

WATER	SUP	PLY V	WELL REI	PORT		LA!		SOURCES DEPT	START CARD#_			
Instruct	ons for	compl	eting this repo				— • • • • •	SOURCES DEPT. A, OREGON				
1) OWN	ER:				ell Number	_#	7	(9) LOCATION OF V			6. d.	
Name CITY OF CONDON								County GILLIAM Latitude Longitude Township 3 N or Range 21 P or W. WM.				
			X 44	5			17000	Township 3	N or \$ kange_ 	SW	G9 OF V	v. vv (v1.
City C	0741	204		State 💍	<u> </u>	Zip	7823	Section 19 Tax Lot 2300 Lo	N Block	Sul	bdivision	
2) TYPE	OF W	ORK	ng 🔲 Alterati	on (ranairh	moondition)	. □ Aher	vlonment	Street Address of Well			_	
3) DRIL	<u>и Пт</u>	LITO D	ng Aiterati	on (repair/	econdition)	LAVAL	rootstrette					
			ry Mud ☐ (Cable	Auger			(10) STATIC WATER	LEVEL:			
Cother 5	7) / L		IALL PE	ROUSS	ION (R	EVER	SEAIR	//'811 ft. belo			ate <u>4-</u>	
NOTHER TOWAL WALL PERCUSSION (REVERSE AIR) 4) PROPOSED USE:								Artesian pressureib. per square incit.				
⊯ Domest			munity 🔲	[ndustrial	☐ Irrig	gation		(11) WATER BEARI	NG ZONES:			
Therma	1	Injec	ction 🔲	Livestock	Oth	er						
(5) BOR	E HO	LE CO	NSTRUCT	ION:				Depth at which water was	first found			
Special Construction approval Yes No Depth of Completed Well/03 ft. Explosives used Yes No Type Amount							1 <u>03</u> IL	From	То	Estimated	Flow Rate	SWL
-		Yes Yes	No Type	SEAL	Amo	unt		35	45	100		131
	OLE	_	\$ 6 - 4 - ml = 1		To	Sacks or p	omnde.	<u> </u>		,,,,,		
Diameter			Material BENTON			Javas VI j						
17	U.	105	PELLET		65	100	#					
			CEMENT									
			BENT.				25x	(12) WELL LOG:				
How was	cal pla	ced:	Method	_A []B 🗆 (D DE	Ground	Elevation			
Othe					20. 11			Materia	<u> </u>	From	To	SWL
Backfill pl			ft. to	ft.	Material		90551	BLACK SAN		0	1	52
Gravel pla				30 IL	Size of §	18VCI (6)	176337		TOPSOLL)		18	
• •	iameter			uge Steel	Plastic	Welded	Threaded	BRN SILTY		Tes) 18	20	
	Q //	1+	2 68.5 13			[8] .		BRN. SILT		1 20		
Casing:	Ø		5 1035			ō		W/SAND- SI	TURATED		35_	
								BRN SA		3.5	11000	_
_				_ □				COARSE	GRAVEL		45	
Liner: _				_ _				FLOW BRE		45	 	<u> </u>
_								ALTEREDIA	BACH AND	. 	 	
Final loca	tion of	shoe(s)	O/OCEPHANA					SEDMENT	ROCK AND		 	
			S/SCREENS) ;				MATE	RIAL		100	
	foration	is .	Method	- 41904	Mate	rial <u>30</u>	455					
∑ Scr		Sk			Tele/pipe	1						
From	To	siz	ze Number	Diameter	size	Casin;	g Liner				<u> </u>	
68.5	98.5	10	70	8								ļ
						_ 🗆						
						_ 🔲					-	
		L				🛮					+	
				-41	la 1 harri			Date started 3 - 4	4-99 Con	npleted 4	4-16	-99
(8) WE	LLTE	212:	Minimum te	sting time	e is t uoni			(unbonded) Water Wel			<u> </u>	
(E) Pr.		_	l Railer	∏Air			owing rtesian	I certify that the work	I performed on the co	nstruction, alte	ration, or al	bandonmen
N.Pump Yield gal/min		_	Bailer Air Drawdown Drill stem at			٠٠٠ـــــــــــــــــــــــــــــــــــ	Time	of this well is in complia Materials used and infor	nce with Oregon water	supply well co	onstruction best of my	standards. knowledge
	D G PA	1	60 I hr.					and belief.				
	<u></u>	1						I DON!	, VV	WWC Nu		730
						L		Signed			_DateS	-11-9
Temperat	ure of v	vater_		-	sian Flow F	ound		(bonded) Water Well C				
Was a water analysis done? Yes By whom								- Laufenman on this feall of	y for the construction, a turing the construction,	dates renorted.	ahove. Ali	work
Did any strata contain water not suitable for intended use?								performed during this ti- construction standards.	he is in compliance yi	th Oregon water	er supply w	ell nd belief
_	_	ıddy	∐Odor □	Colored	Other _			consistiction standards.	Trustebou islane wan		umber	
Depth of	strata:							I I A I N	1. X X	٠,٠,٠٠٠		

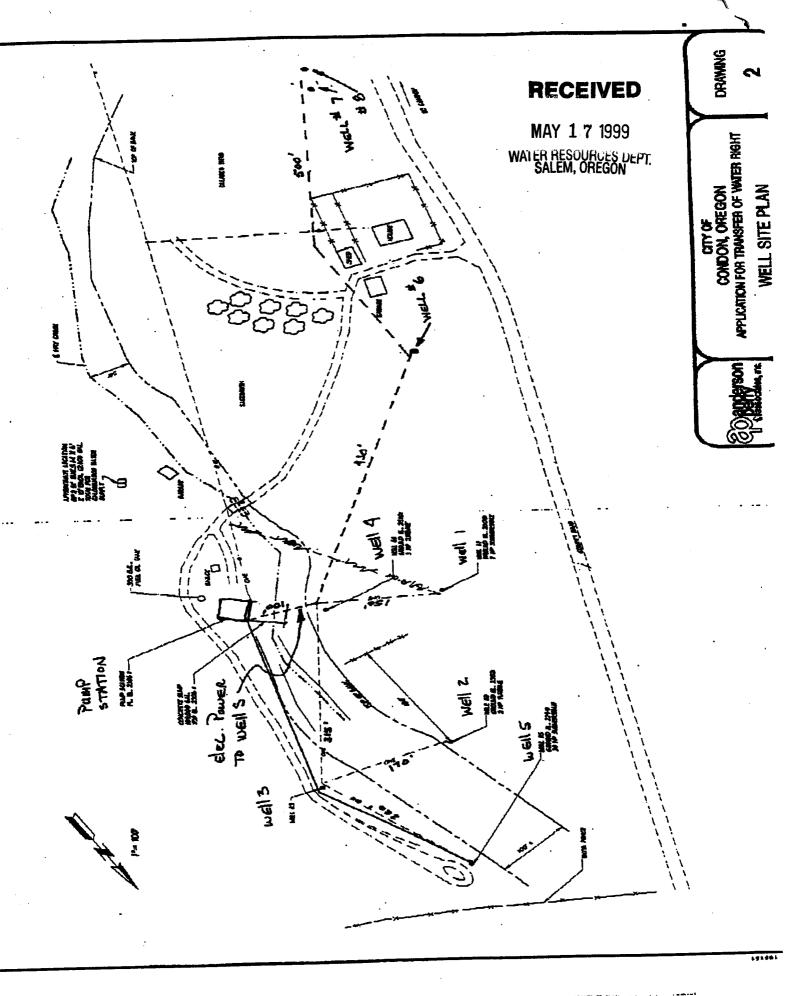

ID : 24 1883