
					Page 1 of 2
STATE OF OREGON	GILL 50	784 WELL I.D. LAB	EL# L 1353	313	
WATER SUPPLY WELL REPORT		START CAP	D # 1045	5795	
(as required by ORS 537.765 & OAR 690-205-0210)	12/9/201	9 ORIGINAL LO	G #		
(1) LAND OWNER Owner Well I.D.		-			
First Name <u>RC</u> Last Name <u>MILLER</u>	(n)			• .• 、	
Company 4M LAND & CATTLE CO.		LOCATION OF WELL (le	-	-	
	Cou	nty <u>GILLIAM</u> Twp <u>1.00</u> N	N/S I	Range 22.00 I	E/W WM
AddressPO BOX 490CityARLINGTONStateORZip97812	— Sec	<u>5</u> <u>NW</u> 1/4 of the <u>SE</u>	1/4	Tax Lot 500	1
City ARLINGTON State OR Zip 97812					
(2) TYPE OF WORK New Well Deepening Conver	rsion Lat	Map Number' or'			DMS or DD
Alteration (complete 2a & 10) Abandonment(com	nplete 5a)	g' or' or' or			DMS or DD
(2a) PRE-ALTERATION	Lon		Nearest a	44	_ DNIS OF DD
Dia + From To Gauge Stl Plstc Wld Thrd		\sim		iddress	
Casing:10 X 252.25 \bigcirc X		55 EIGHTMILE RD. ARLINGTO	N,OR		
Material From To Amt sacks/lbs	PEI	RMIT G-17970			
Seal: Cement 0 50 18 Sacks	(10)				
(3) DRILL METHOD	(10)) STATIC WATER LEVEI			ATT (0)
X Rotary Air Rotary Mud Cable Auger Cable Mud		Existing Well / Pre-Alteration 11/2	Date S	WL(psi) +	SWL(ft)
Reverse Rotary Other					135
		Completed Well 12/6	/2019		135
(4) PROPOSED USE Domestic X Irrigation Community		Flowing Artesian		ry Hole?	
Industrial/ Commericial Livestock Dewatering	WAT	ER BEARING ZONES De	pth water wa	as first found _	
Thermal Injection Other	S	WL Date From To	Est Flow	SWL(psi)	+ SWI (ft)
				5 (1 2 (poi)	
(5) BORE HOLE CONSTRUCTION Special Standard (Ar	ttach copy) 1	2/5/2019 247 306	850		135
Depth of Completed Well 308.00 ft.					
BORE HOLE SEAL	sacks/				
Dia From To Material From To An	100				
	1 S				
12 18 52 Calculated					
10 52 308		WELL LOG Ground El			
		Ground El	evation		
How was seal placed: Method $A \square B \times C \square D$	E	Material		From	То
Other		sting Hole		0	162
Backfill placed from ft. to ft. Material	Blac	ck Basalt w/Yellow Claystone		162	247
Filter pack from ft. to ft. MaterialSize	Blac	Black Basalt w/Blue Claystone 247 2		270	
		wn Scoria w/Blue Claystone		270	290
Explosives used: Yes Type Amount		ti Color Basalt w/Yellow Claystone		290	306
(5a) ABANDONMENT USING UNHYDRATED BENTONIT	E Soft	Black Basalt		306	308
Proposed Amount Actual Amount					
(6) CASING/LINER	I				
Casing Liner Dia + From To Gauge Stl Plstc W	Vld Thrd				
	́п п II—				
	┥┝┥╟──				
	┥┝┥╟──				l
	┥┝┥╟──				l
	┥┝┥╟──				
Shoe Inside Outside Other Location of shoe(s)	⊩				
Temp casing Yes Dia From + To To					
(7) PERFORATIONS/SCREENS					<u> </u>
Perforations Method					L]
Screens Type Material	Dat	e Started11/27/2019	Complete	d <u>12/6/2019</u>	
Perf/ Casing/ Screen Scrn/slot Slot # of	Tele/		-		
Screen Liner Dia From To width length slots	pipe size	bonded) Water Well Constructor			
		rtify that the work I performed on			
		ndonment of this well is in com			
		struction standards. Materials used	and informa	tion reported a	bove are true to
		best of my knowledge and belief.			
	Lice	ense Number 1963	Date	12/9/2019	
(8) WELL TESTS: Minimum testing time is 1 hour					
Pump Bailer Air Flowing Art	Itesian	ned JOHN KLINE (E-filed)			
			4161 41		
Yield gal/min Drawdown Drill stem/Pump depth Duration (hr	· · ·	nded) Water Well Constructor Cer			
850 308 1		cept responsibility for the construct			
700 284 1		k performed on this well during the o			
475 264		ormed during this time is in con			
Temperature 59 °F Lab analysis Yes By		struction standards. This report is tru	e to the best	of my knowle	age and belief.
Water quality concerns? Yes (describe below) TDS amount 195	ppm Lice	ense Number 1881	Date 12	/9/2019	
From To Description Amount	Units				
	Sig	ned GARRY ZOLLMAN (E-filed)		
	Con	tact Info (optional) Garry Zollman			
	I				

ORIGINAL - WATER RESOURCES DEPARTMENT THIS REPORT MUST BE SUBMITTED TO THE WATER RESOURCES DEPARTMENT WITHIN 30 DAYS OF COMPLETION OF WORK Form Version:

WATER SUPPLY WELL REPORT -

continuation page

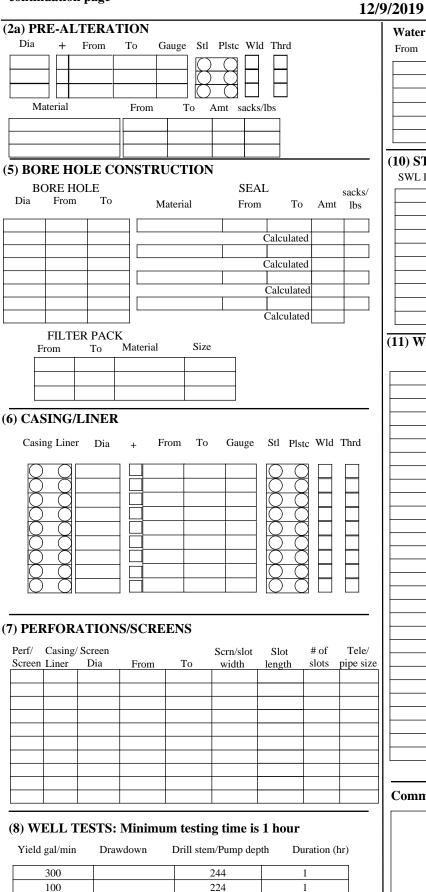

GILL 50784 WELL I.D. LABEL# L 135313 START CARD # 1045795 12/9/2019 ORIGINAL LOG

Page 2 of 2

Water Quality Concerns

From	То	Description	Amount	Units

(10) STATIC WATER LEVEL

SWL Date	From	То	Est Flow	SWL(psi)	+	SWL(ft)
					-	

(11) WELL LOG

Material	From	То
	L	L

Comments/Remarks