

GRAN. 107 Well Record

STATE WELL NO. 9/27-1
COUNTY Grant
APPLICATION NO.

OWNER: City of Monument MAILING ADDRESS:

LOCATION OF WELL: Owner's No. #1 CITY AND STATE:


1/4 1/4 Sec. T. N. E. S., R. W., W.M.

Bearing and distance from section or subdivision corner

Altitude at well

TYPE OF WELL: Date Constructed

Depth drilled 18 Depth cased

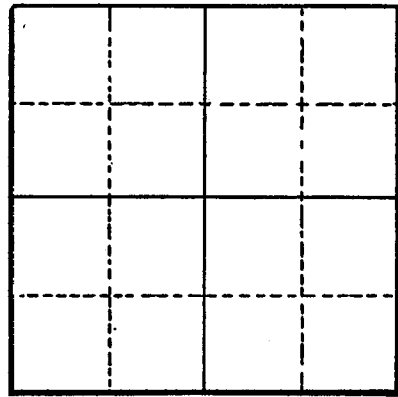

Section

CASING RECORD:

FINISH:

AQUIFERS:

Water comes in well at 14' level rpt.

WATER LEVEL:

PUMPING EQUIPMENT: Type Capacity G.P.M. H.P.

WELL TESTS: Drawdown ft. after hours G.P.M. Drawdown ft. after hours G.P.M.

USE OF WATER Temp. °F. 19

SOURCE OF INFORMATION

DRILLER or DIGGER

ADDITIONAL DATA:

Log Water Level Measurements Chemical Analysis Aquifer Test

REMARKS: