


EXEMPT USE WELL LOCATION MAP

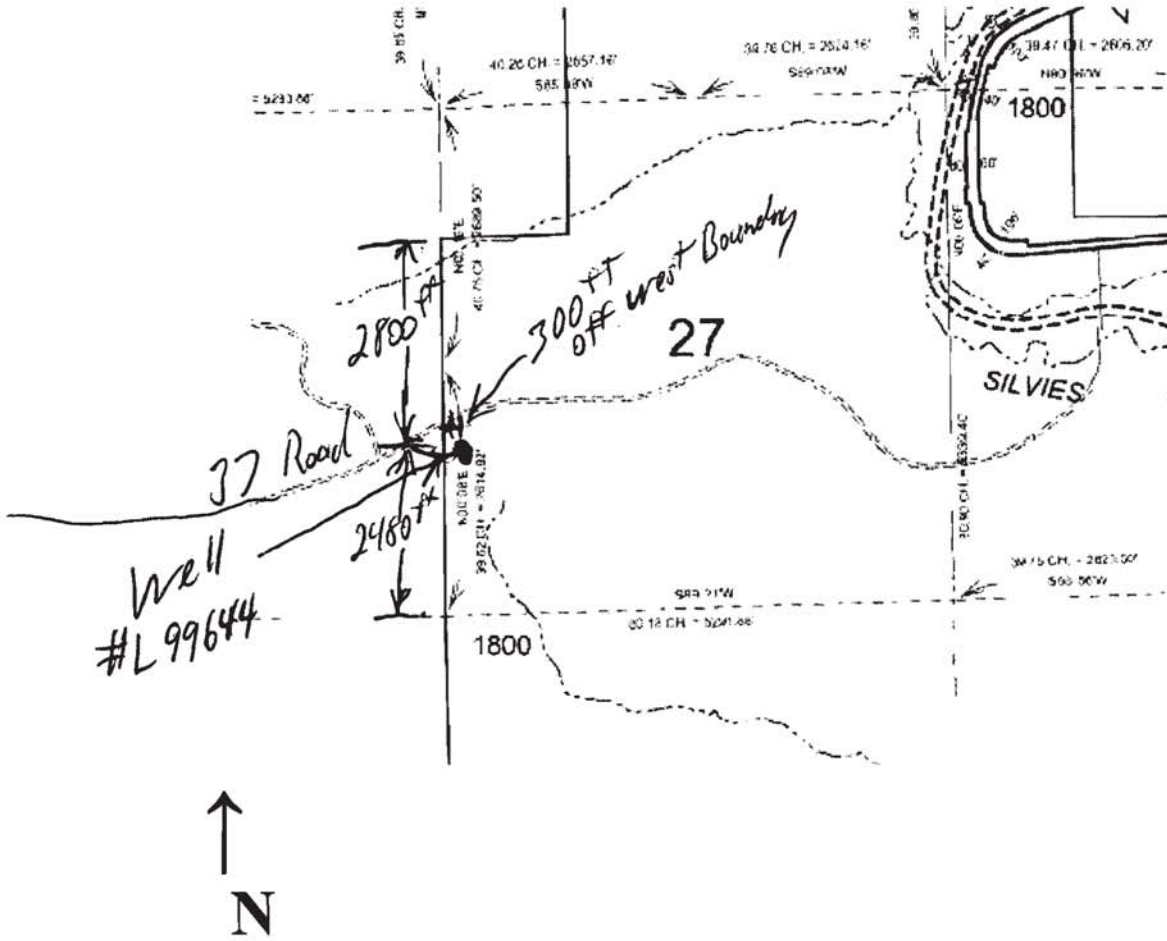

Grant County

Assessor Map Reference Number: 17S 31E 27 SWSW Tax Lot ~~500~~ ¹⁸⁰⁰

Street Address of Well, if Available: 37 Road Hwy 395, Seneca, OR

Well Label (ID) # L 99644

(Please Locate Well and Indicate distance From Property or Survey Corner, See Attached Sample Well Location Map.)

MAP NOT TO SCALE

RECEIVED

OCT 21 2009

WATER RESOURCES DEPT
SALEM, OREGON

LAND OWNER SUBMITTED MAP