

STATE ENGINEER
Salem, Oregon

Well Record

STATE WELL NO. 16/31-34R(1)
COUNTY Grant
APPLICATION NO. U-30

GRAN. 783

OWNER: Edward Hines Lumber Co.


MAILING ADDRESS:

LOCATION OF WELL: Owner's No. Seneca

CITY AND STATE: Burns, Oregon

SE 1/4 SE 1/4 Sec. 34 T. 16 N. S., R. 31 E. W.M.

Bearing and distance from section or subdivision corner 838' N. & 65' W. from SE cor. Sec. 34

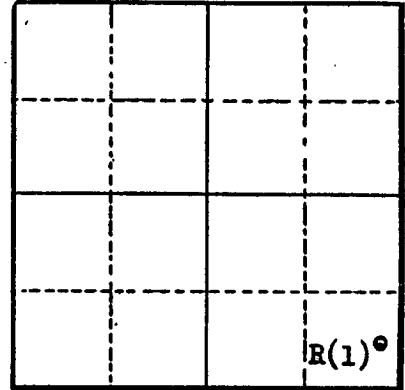

Section

Altitude at well

TYPE OF WELL: Drilled Date Constructed 1930

Depth drilled 330 Depth cased

CASING RECORD:

8-inch

FINISH:

AQUIFERS:

WATER LEVEL:

PUMPING EQUIPMENT: Type turbine H.P. 20
Capacity 300 G.P.M.

WELL TESTS:

Drawdown ft. after hours G.P.M.
Drawdown ft. after hours G.P.M.

USE OF WATER Temp. °F., 19

SOURCE OF INFORMATION

DRILLER or DIGGER

ADDITIONAL DATA:

Log Water Level Measurements Chemical Analysis Aquifer Test

REMARKS:

Well flows during spring and early summer, ceases to flow in dry season