

HARN 1093

STATE ENGINEER
Salem, Oregon

Well Record


STATE WELL NO. 25/30-27F(1)
COUNTY Harney
APPLICATION NO. U-436

1093
Harn

OWNER: James E. Harn MAILING ADDRESS: Box 895

LOCATION OF WELL: Owner's No. CITY AND STATE: Burns, Oregon

SE 1/4 NW 1/4 Sec. 27 T. 25 N. S., R. 30 W., W.M.
Bearing and distance from section or subdivision
corner 70 ft. N. from center of section

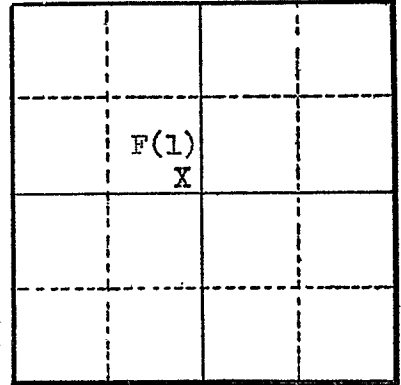

Altitude at well

TYPE OF WELL: Bored Date Constructed

Depth drilled 50 Depth cased 0

Section 27

CASING RECORD: 52 inch diameter

FINISH: Open hole

AQUIFERS: Cinders from 32 to 50 ft.

WATER LEVEL: 33 1/2 8/13/58

PUMPING EQUIPMENT: Type Parma lifter H.P.
Capacity G.P.M.

WELL TESTS:
Drawdown ft. after hours G.P.M.
Drawdown ft. after hours G.P.M.

USE OF WATER Irrigation Temp. °F., 19
SOURCE OF INFORMATION G-436

DRILLER or DIGGER
ADDITIONAL DATA:
Log X Water Level Measurements X Chemical Analysis Aquifer Test

REMARKS:

Well Log Of
James E. Dunn Well

Located $\frac{1}{2}$ of Sec 27, T.25S., R30 EWM.
Harney County, Ore.

- 0 - 5' Surface Soil
- 5 - 25' Sandy Shale.
- 25' - 32' Hard Shale.
- 32' - 50' Volcanic Cinder Gravel. - Water

James E. Dunn