

STATE ENGINEER  
Salem, Oregon

*Harney*  
*0/2*

# Well Record


STATE WELL NO. 19/32-18E(1)  
COUNTY Harney  
APPLICATION NO. G-31

OWNER: Edward Hinds Lumber Co. MAILING ADDRESS: .....

LOCATION OF WELL: Owner's No. Trout Cr. Well CITY AND STATE: Burns, Oregon

.....  $\frac{1}{4}$  .....  $\frac{1}{4}$  Sec. .... T. .... N. S., R. .... E. W., W.M.

Bearing and distance from section or subdivision corner S. 0° 17' E. 2226' from NE cor. Sec. 13

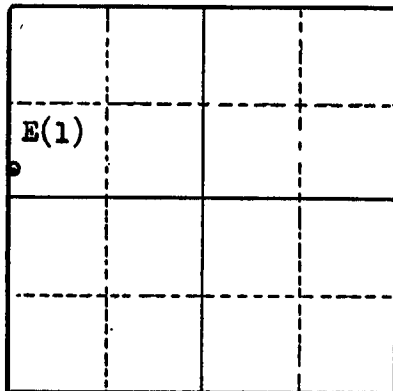

Section 18

Altitude at well .....

TYPE OF WELL: ..... Date Constructed .....

Depth drilled 32 Depth cased .....

### CASING RECORD:

12-inch

### FINISH:

### AQUIFERS:

### WATER LEVEL:

PUMPING EQUIPMENT: Type Centrifugal H.P. 5  
Capacity 200 G.P.M.

WELL TESTS:  
Drawdown ..... ft. after ..... hours ..... G.P.M.  
Drawdown ..... ft. after ..... hours ..... G.P.M.

USE OF WATER Railroad Temp. .... °F. ...., 19.....

SOURCE OF INFORMATION G-31

DRILLER or DIGGER .....

ADDITIONAL DATA:  
Log ..... Water Level Measurements ..... Chemical Analysis ..... Aquifer Test .....

### REMARKS: