NOTICE TO WATER WELL CONTRACTOR

The original and first copy of this report
are to be filed with the


WATER RESOURCES DEPARTMENT, SALEM, OREGON 97310 within 30 days from the date of well completion.

WATER WELL REPORT

STATE OF OREGON

- (Please type or print)

(Do not write above this line)

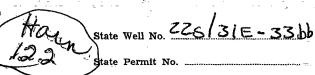

(10) LOCATION OF WELL: (1) OWNER: County HATHEY Driller's well number NW 1 NW 1 Section 33 T.225 R. 31 E Bearing and distance from section or subdivision corner (2) TYPE OF WORK (check): New Well 🕱 Deepening [Reconditioning [Abandon 🔲 If abandonment, describe material and procedure in Item 12. (11) WATER LEVEL: Completed well. (3) TYPE OF WELL: (4) PROPOSED USE (check): Depth at which water was first found Driven | Domestic 🐹 Industrial 🗆 Municipal 🗀 97 ft. below land surface. Date 6/16/ Irrigation Z Test Well Other Dug Artesian pressure lbs. per square inch. Date CASING INSTALLED: Threaded | Welded | (12) WELL LOG: Diameter of well below casing .. 12 " Diam from 0 ft to 48 ft Gage 7350 Depth drilled 320 ft. Depth of completed well " Diam. from ft. to ft. Gage Formation: Describe color, texture, grain size and structure of materials; and show thickness and nature of each stratum and aquifer penetrated, with at least one entry for each change of formation. Report each change in PERFORATIONS: position of Static Water Level and indicate principal water-bearing strata. Perforated? Tyes X No. Type of perforator used MATERIAL Soil and graves Size of perforations in, by 0 40 SANDSTONE perforations from _____ ft. to _____ 20 0 BASALT, Red perforations from _____ft. to ____ 40 55 0 brown くり 90 100 (7) SCREENS: Well screen installed? | Yes 100 Manufacturer's Name 125 140 140 155 Diam. Slot size Set from AY, HARC HIBWA, ROCK 265 270 270 305 SANDSTONE Drawdown is amount water level is lowered below static level HARNEY Co (8) WELL TESTS: 205 315 Was a pump test made? Yes | No If yes, by whom? From Supple Yield: 280 gal./min. with /Sft. drawdown after 8 hrs: JUN 28 197 WATER RESOURCES DERT Bailer test gal./min. with ft. drawdown after SALEM, OREGON g.p.m. perature of water 52 Depth artesian flow encountered _____ ft. 19 79 Completed Date well drilling machine moved off of well 1979 (9) CONSTRUCTION: Drilling Machine Operator's Certification: This well was constructed under my direct supervision. Materials used and information reported above are true to my Well sealed from land surface to best knowledge and belief.

[Signed] Having Machine Operator)

Date 6/16, 19.77. Diameter of well bore to bottom of seal Diameter of well bore below seal ______in. Number of sacks of cement used in well seal Drilling Machine Operator's License No. ______//88 Number of sacks of cement used in well seal

How was cement grout placed?

AROUT PUMP Water Well Contractor's Certification: This well was drilled under my jurisdiction and this report is true to the best of my knowledge and belief. Was a drive shoe used? 💢 Yes 🗌 No Plugs Size: location ft. Name MARGIC I Woodkuff
(Person, firm or corporation) Did any strata contain unusable water? 🔲 Yes 👿 No Type or print) Type of water? depth of strata Method of sealing strata off Was well gravel packed? Yes No Size of gravel: ... Confractor's License No. 7/1 Date 6/16