

NC

25/34-7 B

NOTICE TO WATER WELL CONTRACTOR

The original and first copy of this report are to be filed with the

STATE ENGINEER, SALEM 10, OREGON within 30 days from the date of well completion.

RECEIVED SEP 22 1965 STATE ENGINEER SALEM OREGON

WATER WELL REPORT

State Well No. 25/34-7 B

State Permit No.

(1) OWNER:

Name Crane School Dist #1 Address Crane, Oregon

(2) LOCATION OF WELL:

County Harney Driller's well number 7 T. 25 S R. 34 E W.M. Bearing and distance from section or subdivision corner 50' from N.E. Corner of school building

(3) TYPE OF WORK (check):

New Well [checked] Deepening [] Reconditioning [] Abandon []

(4) PROPOSED USE (check):

Domestic [checked] Industrial [] Municipal [] Irrigation [] Test Well [] Other []

(5) TYPE OF WELL:

Rotary [] Driven [] Cable [checked] Jetted [] Dug [] Bored []

(6) CASING INSTALLED:

6" Diam. from 0 ft. to 120 ft. Gage 250

(7) PERFORATIONS:

Perforated? [] Yes [checked] No [] Type of perforator used Size of perforations in. by in. perforations from ft. to ft.

(8) SCREENS:

Well screen installed? [] Yes [checked] No [] Manufacturer's Name Type Model No. m. Slot size Set from ft. to ft. Diam. Slot size Set from ft. to ft.

(9) CONSTRUCTION:

Well seal—Material used in seal bentonite Depth of seal 30 ft. Was a packer used? no Diameter of well bore to bottom of seal 8" in. Were any loose strata cemented off? [] Yes [checked] No [] Depth Was a drive shoe used? [checked] Yes [] No [] Was well gravel packed? [] Yes [checked] No [] Size of gravel: Gravel placed from ft. to ft. Did any strata contain unusable water? [] Yes [checked] No [] Type of water? Depth of strata Method of sealing strata off

(10) WATER LEVELS:

Static level 24' ft. below land surface Date 9/16/65 Artesian pressure lbs. per square inch Date


(11) WELL TESTS:

Drawdown is amount water level is lowered below static level Was a pump test made? [] Yes [checked] No [] If yes, by whom? Yield: 100 gal./min. with 60 ft. drawdown after 14 hrs.

(12) WELL LOG:

Diameter of well below casing 6" Depth drilled 185 ft. Depth of completed well 185 ft. Formation: Describe by color, character, size of material and structure, and show thickness of aquifers and the kind and nature of the material in each stratum penetrated, with at least one entry for each change of formation.

Table with columns MATERIAL, FROM, TO. Rows include TOP SOIL, HARD PAN, CLAY + SAND STREAKS, SMALL GRAVEL + CLAY, COURSE SAND, CEMENT GRAVEL, BLUE SHALE ROCK.

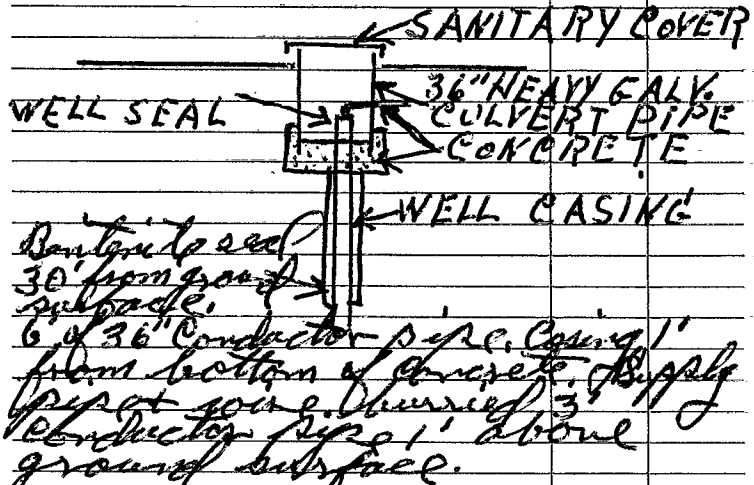

Work started 9/3 1965 Completed 9/17 1965 Date well drilling machine moved off of well 9/18/65 19

(13) PUMP:

Manufacturer's Name Advance Type: submersible H.P. 5

Water Well Contractor's Certification:

This well was drilled under my jurisdiction and this report is true to the best of my knowledge and belief.

NAME John W. Rossberg (Person, firm or corporation) (Type or print)

Address Drilling Machine Operator's License No. 269

[Signed] John W. Rossberg (Water Well Contractor) Contractor's License No. 272 Date 9/17 1965