

STATE ENGINEER
Salem, Oregon

1392
Harney

Well Record

STATE WELL NO. 26/33-19N(1)
COUNTY Harney
APPLICATION NO. 6-2396

DE B. FORSLUND

OWNER: R. J. Gorbin


MAILING ADDRESS:

LOCATION OF WELL: Owner's No.

CITY AND STATE:

SW 1/4 SW 1/4 Sec. 19 T. 26 N. S., R. 33 E. W., W.M.

Bearing and distance from section or subdivision corner 250' N. & 15' E. from SW cor. Sec. 19

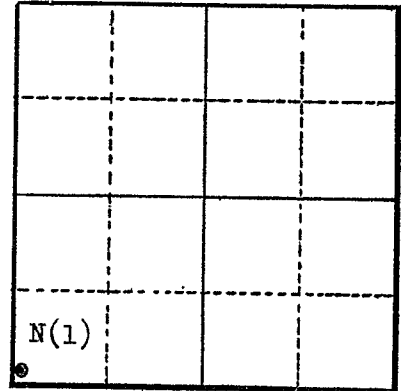

Section 19

Altitude at well 4134'

TYPE OF WELL: Drilled Date Constructed

Depth drilled 117 Depth cased

CASING RECORD:

12-inch

FINISH:

AQUIFERS:

WATER LEVEL:

PUMPING EQUIPMENT: Type H.P.
Capacity G.P.M.

WELL TESTS:
Drawdown ft. after hours G.P.M.
Drawdown ft. after hours G.P.M.

USE OF WATER Temp. °F., 19

SOURCE OF INFORMATION J.

DRILLER or DIGGER Jack McClure

ADDITIONAL DATA:

Log Water Level Measurements Chemical Analysis Aquifer Test

REMARKS: