

STATE ENGINEER
Salem, Oregon

1393
Horn

OBSERVATION WELL

Well Record

STATE WELL NO. 26/33-19R(1)
COUNTY Harney
APPLICATION NO. G62584

OWNER: DE R. FORSLUND
Earl V. Horning


MAILING ADDRESS: Route 2, Box 22

LOCATION OF WELL: Owner's No.

CITY AND STATE: Moscow, Idaho

SE 1/4 SE 1/4 Sec. 19 T. 26 N. S., R. 33 W., W.M.

Bearing and distance from section or subdivision
corner 62' N. & 55' E. of SW cor. of SE 1/4 SE 1/4,
Section 19, T. 26 S., R. 33 E.

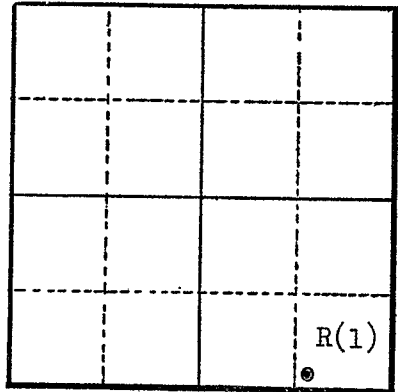

Altitude at well 4111'

TYPE OF WELL: Drilled Date Constructed Sept.-Oct. 1955

Depth drilled 97 Depth cased

Section 19

CASING RECORD:

FINISH:

AQUIFERS:

WATER LEVEL:

15' below land surface, October 1955

PUMPING EQUIPMENT: Type Turbine H.P.
Capacity 1400 G.P.M.

WELL TESTS:

Drawdown 2' 8" ft. after 11 hours pumping 1150 G.P.M.
Drawdown ft. after hours G.P.M.

USE OF WATER Irrigation Temp. °F. 19

SOURCE OF INFORMATION Well report in U-803

DRILLER or DIGGER Jack McClure

ADDITIONAL DATA:

Log Water Level Measurements Chemical Analysis Aquifer Test

REMARKS:

